State of Alaska
Department of Fish and Game
Nomination for Waters
Important to Anadromous Fish

1986
Year of Revision

TB 10-11-85

Anadromous Water Catalog Volume ~~Southeastern Region I~~

~~86-227~~
86-227

USGS Quad Petersburg A-5 (6)

Name of Waterway

Anadromous Water Catalog Number of Waterway
105-43-10060

Change to X Atlas
Catalog
Both

Addition
Deletion
Correction X

Name addition:
USGS name
Local name

ALASKA DEPT. OF
FISH & GAME
SEP 20 1985
HABITAT
REGIONAL OFFICE

For Office Use

Nomination #

Richard Reed 9/19/85
Regional Supervisor Date

OK SJS 10/23/85

C
Drafted Date

Species	Date(s) Observed	Spawning	Rearing	Migration
Coho	5/29/85		X	
Dolly Varden	5/29/85		X	
Pinks	9/6/85	X		

Comments: Provide any clarifying information, including number of fish observed, location of fish survey data, etc.

There isn't a barrier as indicated in the Atlas. There is a small 1 m. bedrock falls. Coho and Dolly Varden fry were abundant. The entire system was flown by helicopter. Pink salmon were abundant throughout the system.

Attach a copy of a map showing location of mouth and upper points of each species, specific stream reaches identified for spawning or rearing, locations of barriers, such as falls. Attach a copy of the fish survey data, if available.

Name of Observer (please print) James P. Caniello

Date: 9/10/85 Signature: James P. Caniello

Address: Box 667 Petersburg, Ak. 99833

Signature of Area Biologist:

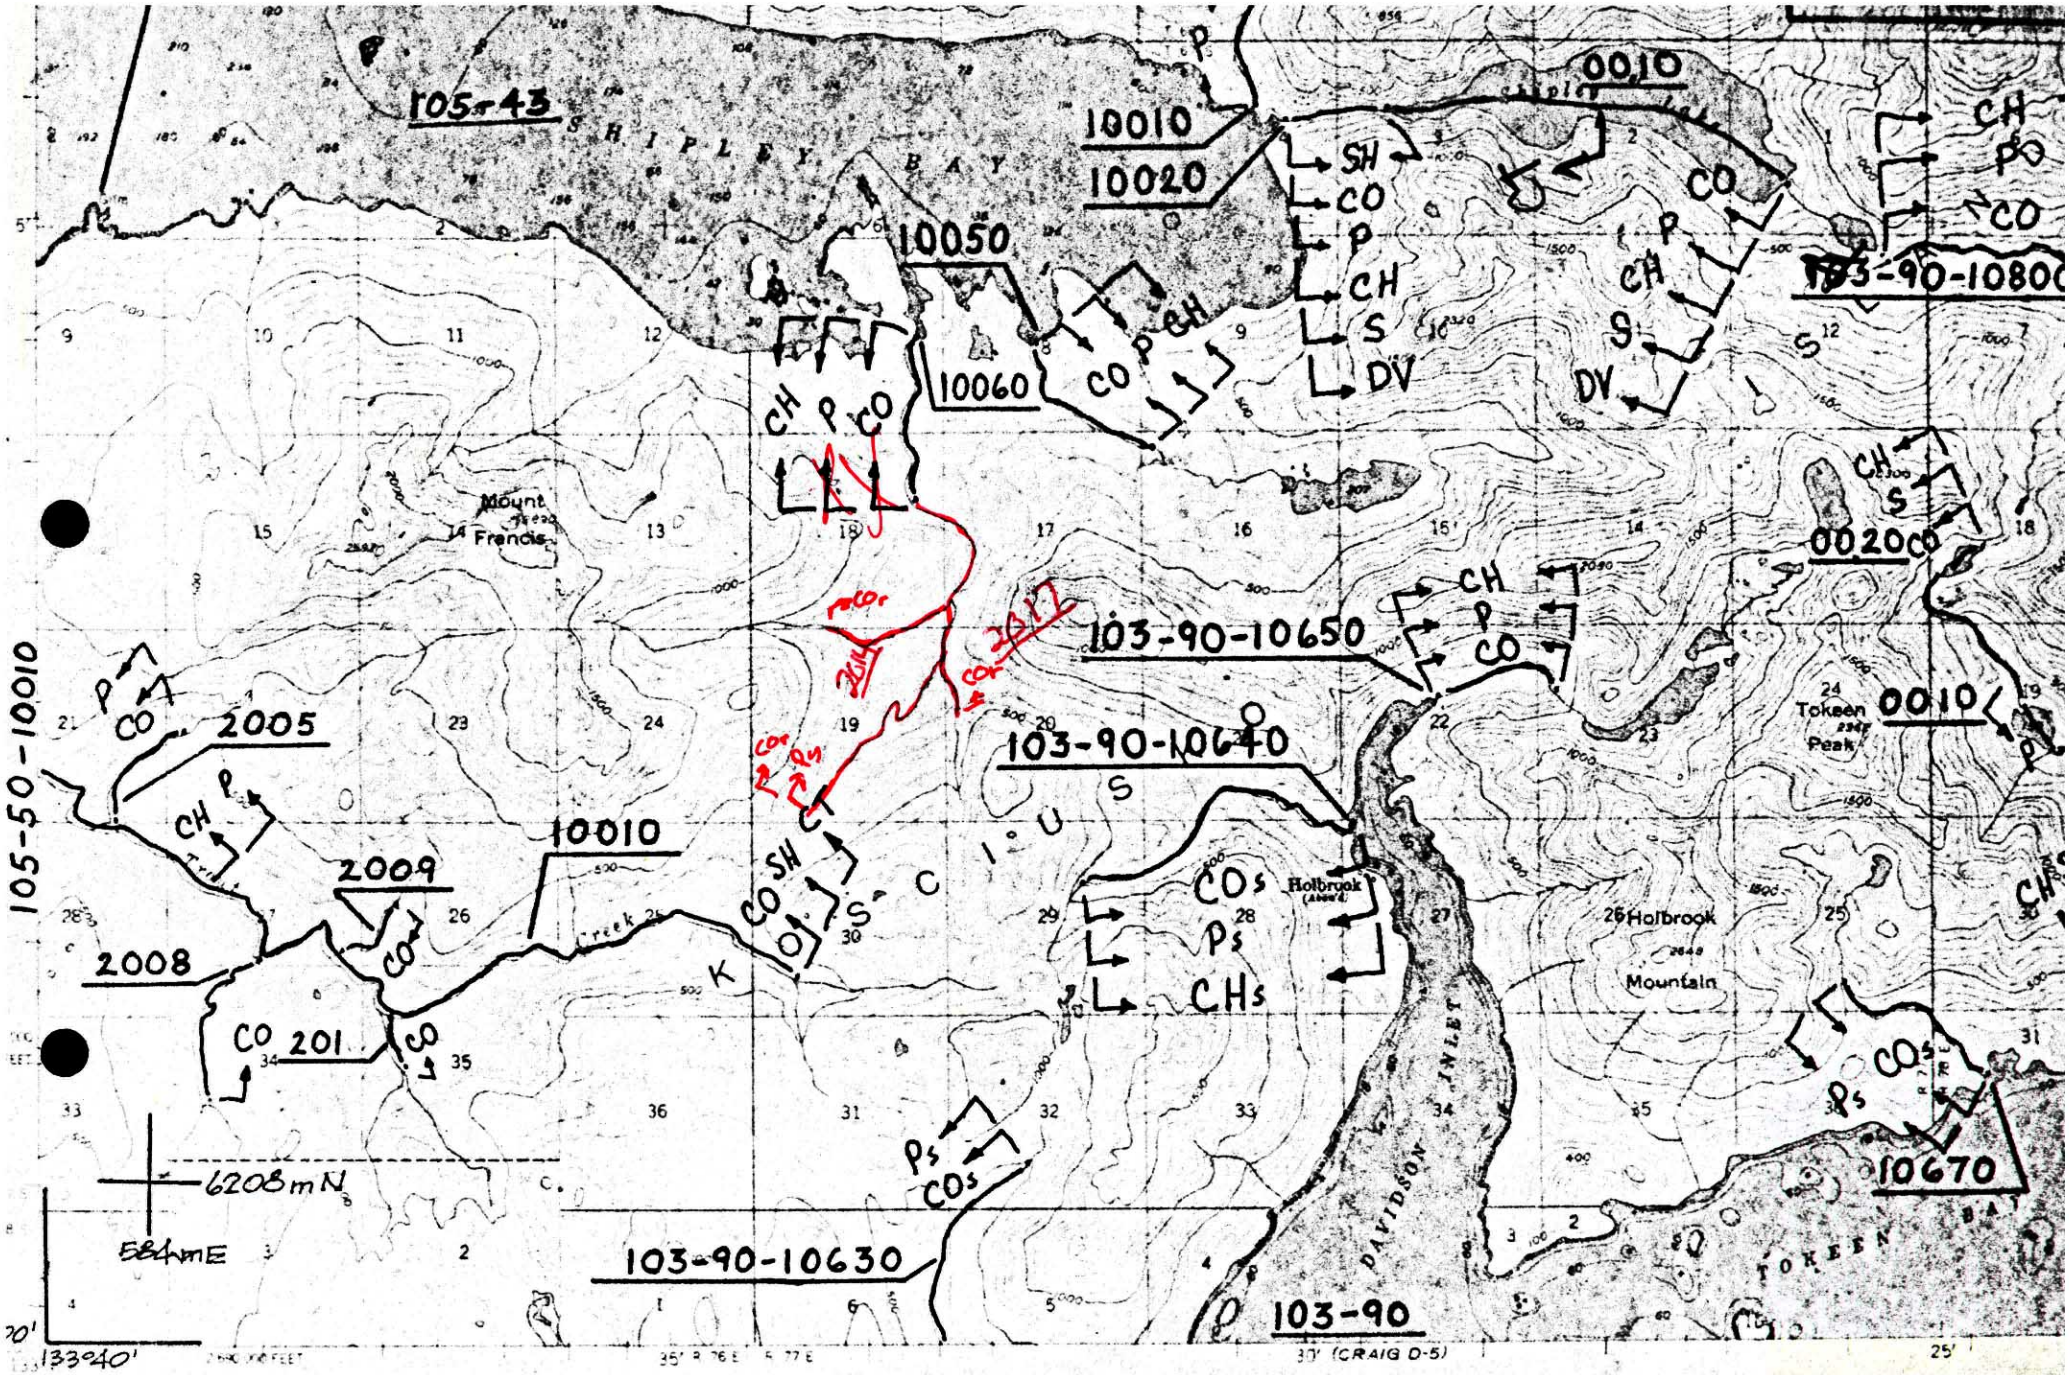

Mapped, edited, and published by the Geological Survey

Control by USC&GS

Topography by photogrammetric methods from aerial photographs taken 1948. Field annotated 1949. Map not field checked

Shoreline and hydrographic data compiled from USC&GS Charts 8120 (1951), 8171 (1949), 8172 (1951), and 8201 (1951) (1:217,828 scale)

This information is not intended for navigational purposes

Universal Transverse Mercator projection. 1927 North American datum

TRUE NORTH
MAGNETIC NORTH

From Anadromous Stream Atlas
Revised April 1982

CONTOUR INTERVAL 100 FEET
DATUM IS MEAN SEA LEVEL

ALASKA

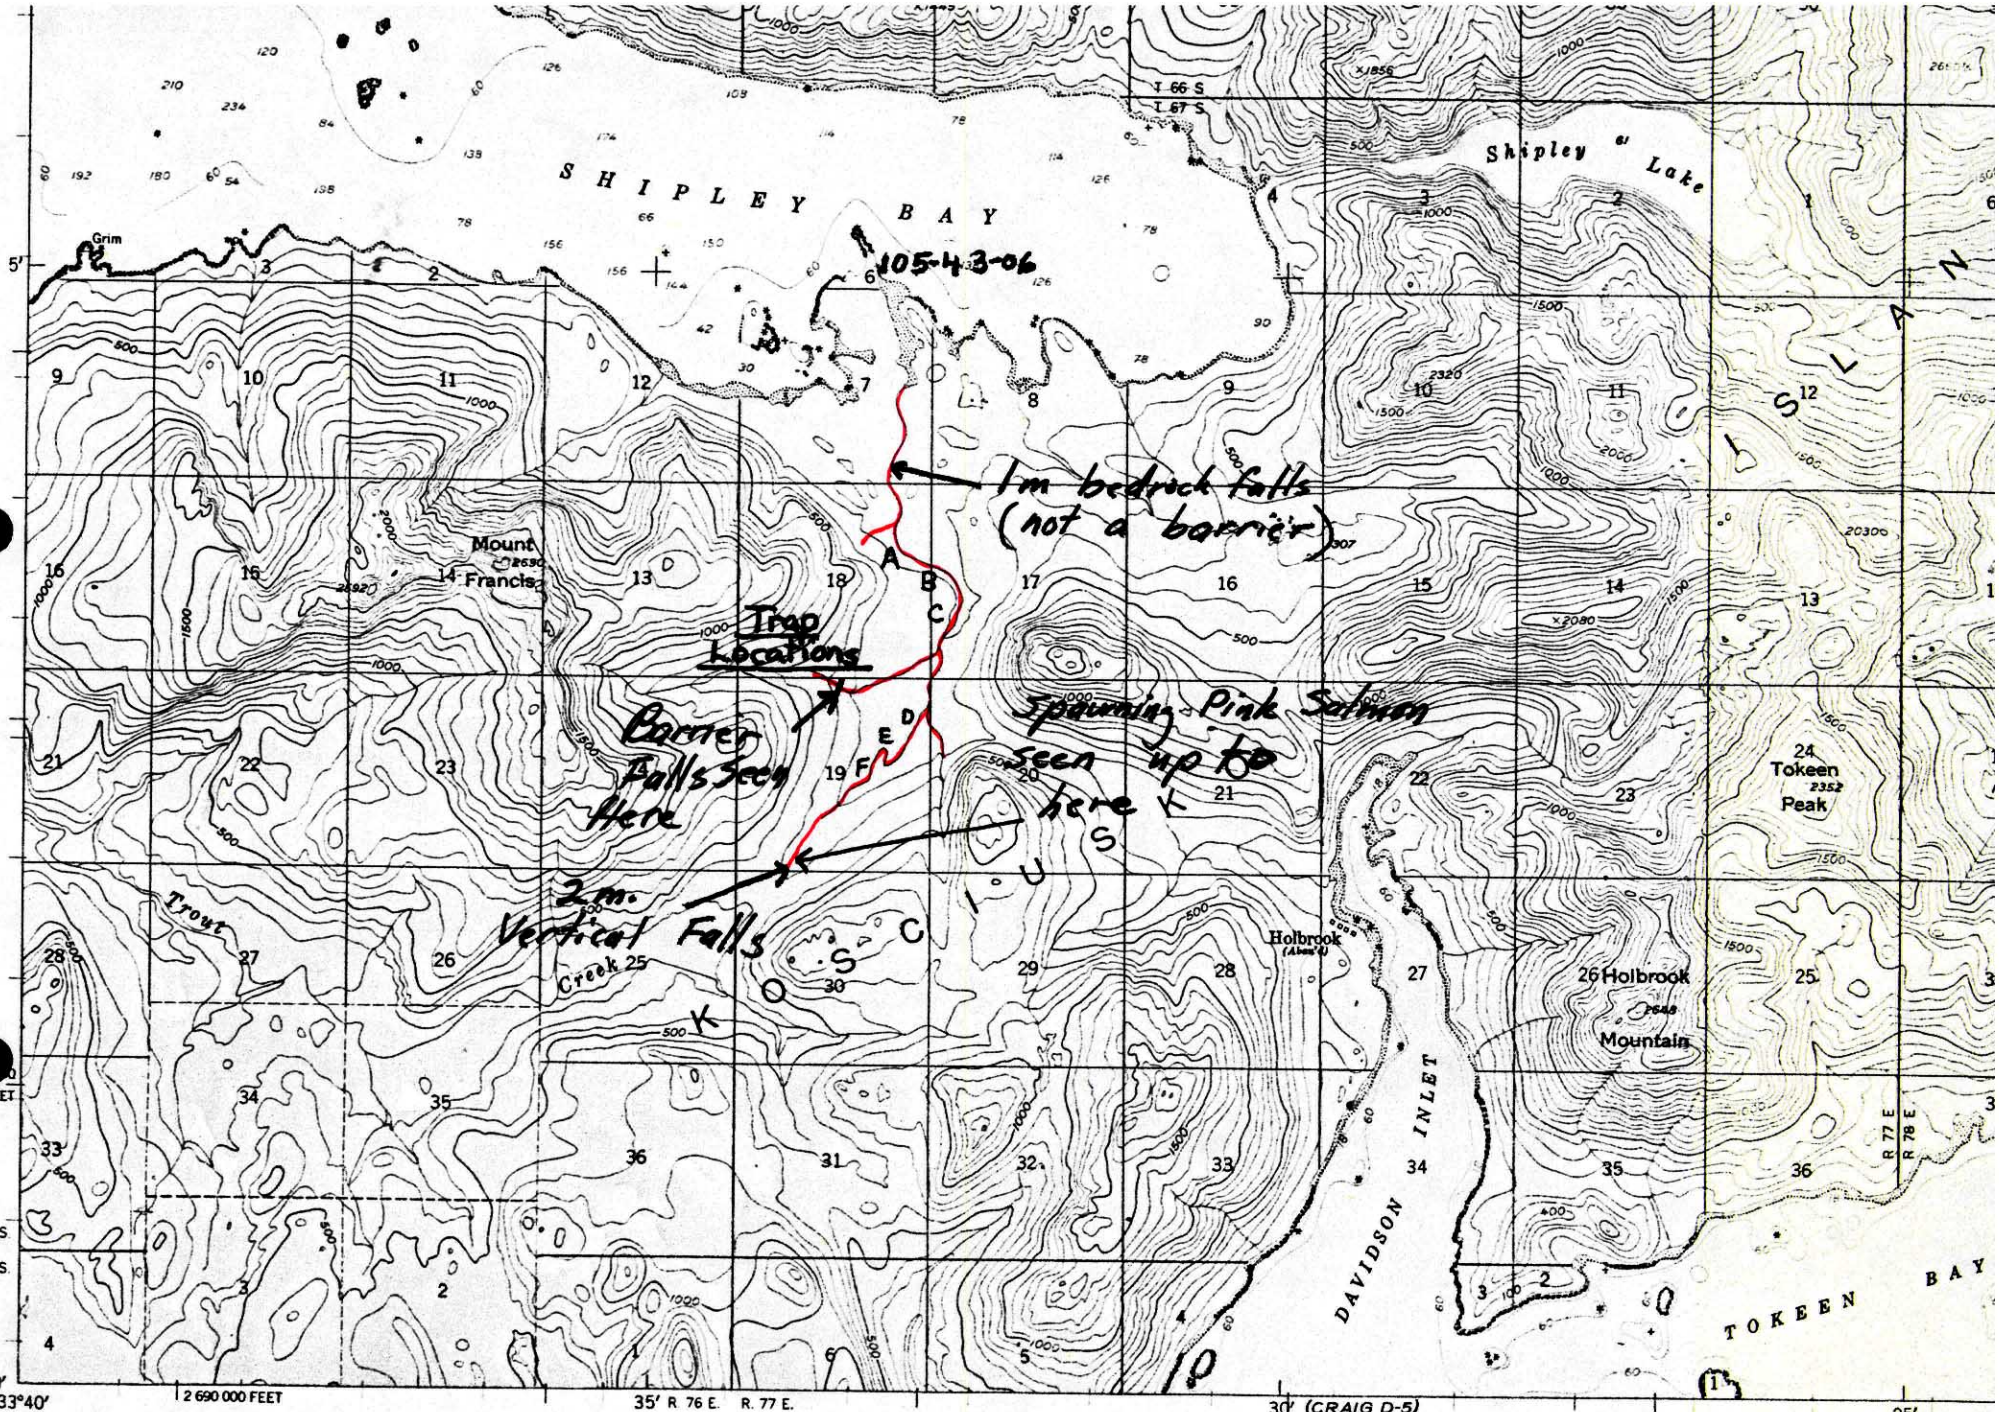

Mapped, edited, and published by the Geological Survey

Control by USC&GS

Topography by photogrammetric methods from aerial photographs taken 1948, field annotated 1949. Map not field checked

Selected hydrographic data compiled from USC&GS Charts 8120 (1951) 8171 (1949), 8172 (1951), and 8201 (1951) (1:217,828 scale)

This information is not intended for navigational purposes

SCALE 1:63360

4 MILES

21000 FEET

5 KILOMETERS

SS - Coho Salmon
DV - Dolly Varden

FISH SAMPLING FORM

Stream Name _____ ADF&G Catalog No. 105-43-06 Date 5/29/85

Identify Survey Area A-F (see map) Water Temp. — Bait Used Eggs

	Trap	Time In	Time Out	Species	Length	Comments
A	1	30 min.		2 DV		
	2	"	"	∅		
	3	"	"	30 SS 35 DV		
B	4	"	"	18 DV 1 SS		
	5	"	"	∅		
	6	"	"	∅		
C	7	"	"	40 DV 2 SS		
	8	"	"	8 DV 1 SS		
	9	"	"	10 DV 2 SS		
D	10	"	"	∅		
	11	"	"	6 DV 2 SS		
	12	"	"	8 DV 5 SS		
E	13	"	"	1 SS		Fry were numerous between here and the last trap location
	14	"	"	∅		
	15	"	"	∅		
F	16	"	"	∅		Fry were seen around the traps but it was difficult to find a pool deep enough to se the traps.
	17	"	"	∅		
	18	"	"	∅		

This form is used to record fish caught during Level Three, Four, or Five Surveys.