State of Alaska
Department of Fish and Game
Nomination for Waters
Important to Anadromous Species

1986
Year of Revision
86-270

Approved

Richard Reed 9/6/85
Regional Supervisor Date

OK SJS 10/23/85

TB 9-23-85
Drafted

Name of Waterway _____

AWC# of Waterway 115-32-10250-2052-3012

AWC Volume & Number _____

USGS Quad Skagway C-3 ~~B-3~~

Addition x
Deletion _____
Correction _____
Change _____

Change to _____ Atlas
_____ Catalog
x Both

Species	Date(s) Observed	Spawning	Rearing	Migration
Pink Salmon	8-13-85	✓		
Dolly Varden	8-13-85		✓	
Coho Salmon	8-13-85		✓	
Whitefish	8-13-85			✓

Comments: Provide any clarifying information, including number of fish observed, location of fish survey data, etc.

This is a tributary of Assignation Creek 115-32-10250-2052
It is a clear running stream. Two Whitefish and approx. 10 ~~Pi~~ Spawning Pink Salmon were seen in the creek. Four baited minnow traps set 16 hrs. captured 12 Dolly Varden and 83 coho salmon.

Attach a copy of a map showing location of mouth and upper points of each species, specific stream reaches identified for spawning or rearing, locations of barriers, such as falls. Attach a copy of the fish survey data, if available.

Name of Observer (please print) Randolph Ericksen

Date: 8-22-85 Signature: Randolph P. Ericksen

Address: ADF+G Box 431
Haines, Alaska 99827

ALASKA DEPT. OF FISH & GAME
SEP 10 1985
HABITAT
REGIONAL OFFICE

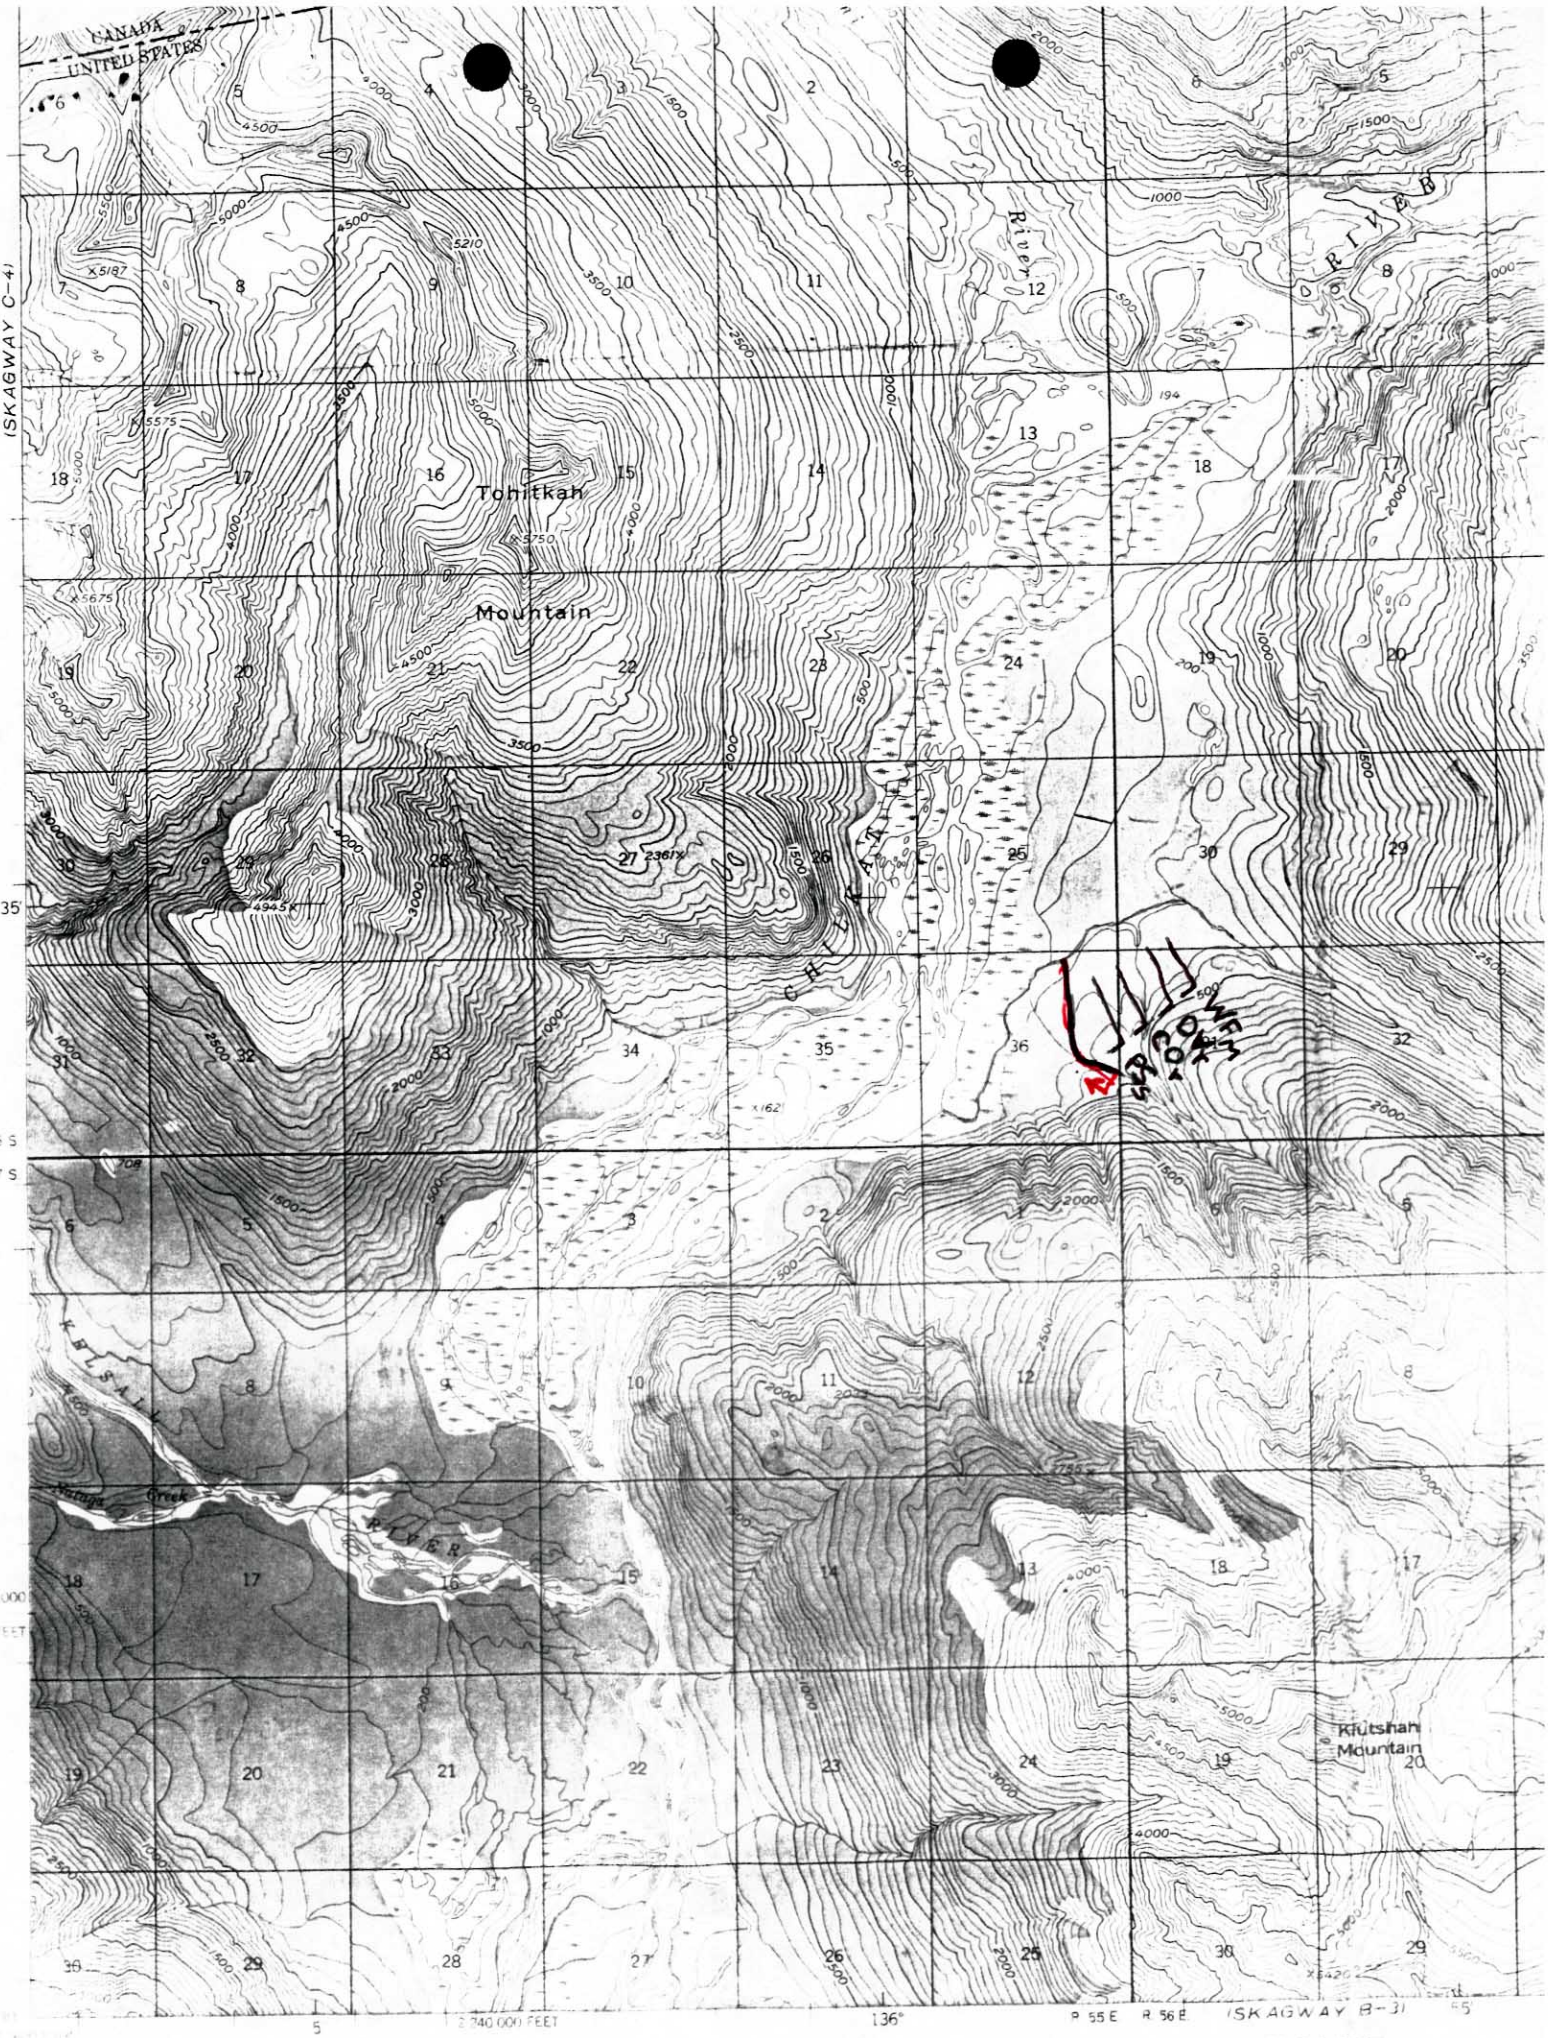

Mapped, edited, and published by the Geological Survey

SCALE 1:63 360