State of Alaska
Department of Fish and Game
Nomination for Waters
Important to Anadromous Fish

88
Year of Revision
88-130

HABITAT
RECEIVED
OCT 15 1987
REGION I
JUNEAU

Anadromous Water Catalog Volume SE I

USGS Quad (15) YAKUTAT C-4

Name of Waterway Trib to East ~~Br~~ Branch Seal Ck

Anadromous Water Catalog Number of Waterway
182-70
~~181-60~~-11600-2005 (?) -3005

Change to _____ Atlas
_____ Catalog
x Both

Addition x

Deletion _____

Correction _____

Name addition:

USGS name NONE

Local name Forest Highway 10 mile 18.2

For Office Use

Nomination # _____

Richard Reed 10/26/87
Regional Supervisor Date

_____ _____

EI 11/17/87
Drafted Date

Species	Date(s) Observed	Spawning	Rearing	Migration
SS Coho	6/2/87		x	x

Comments: Provide any clarifying information, including number of fish observed, location of fish survey data, etc.

Fry Trap set 1400hrs pulled 1605 hrs
catch - 1 SS
others observed outside the trap
upstream Forest Highway 10

Attach a copy of a map showing location of mouth and upper points of each species, specific stream reaches identified for spawning or rearing, locations of barriers, such as falls. Attach a copy of the fish survey data, if available.

Name of Observer (please print) Robert E Johnson

Date: 10/14/87 Signature: Robert E Johnson

Address: ADFG SPORT FISH
Box 68 YAKUTAT AK 99689

Signature of Area Biologist: Janet E. Hall

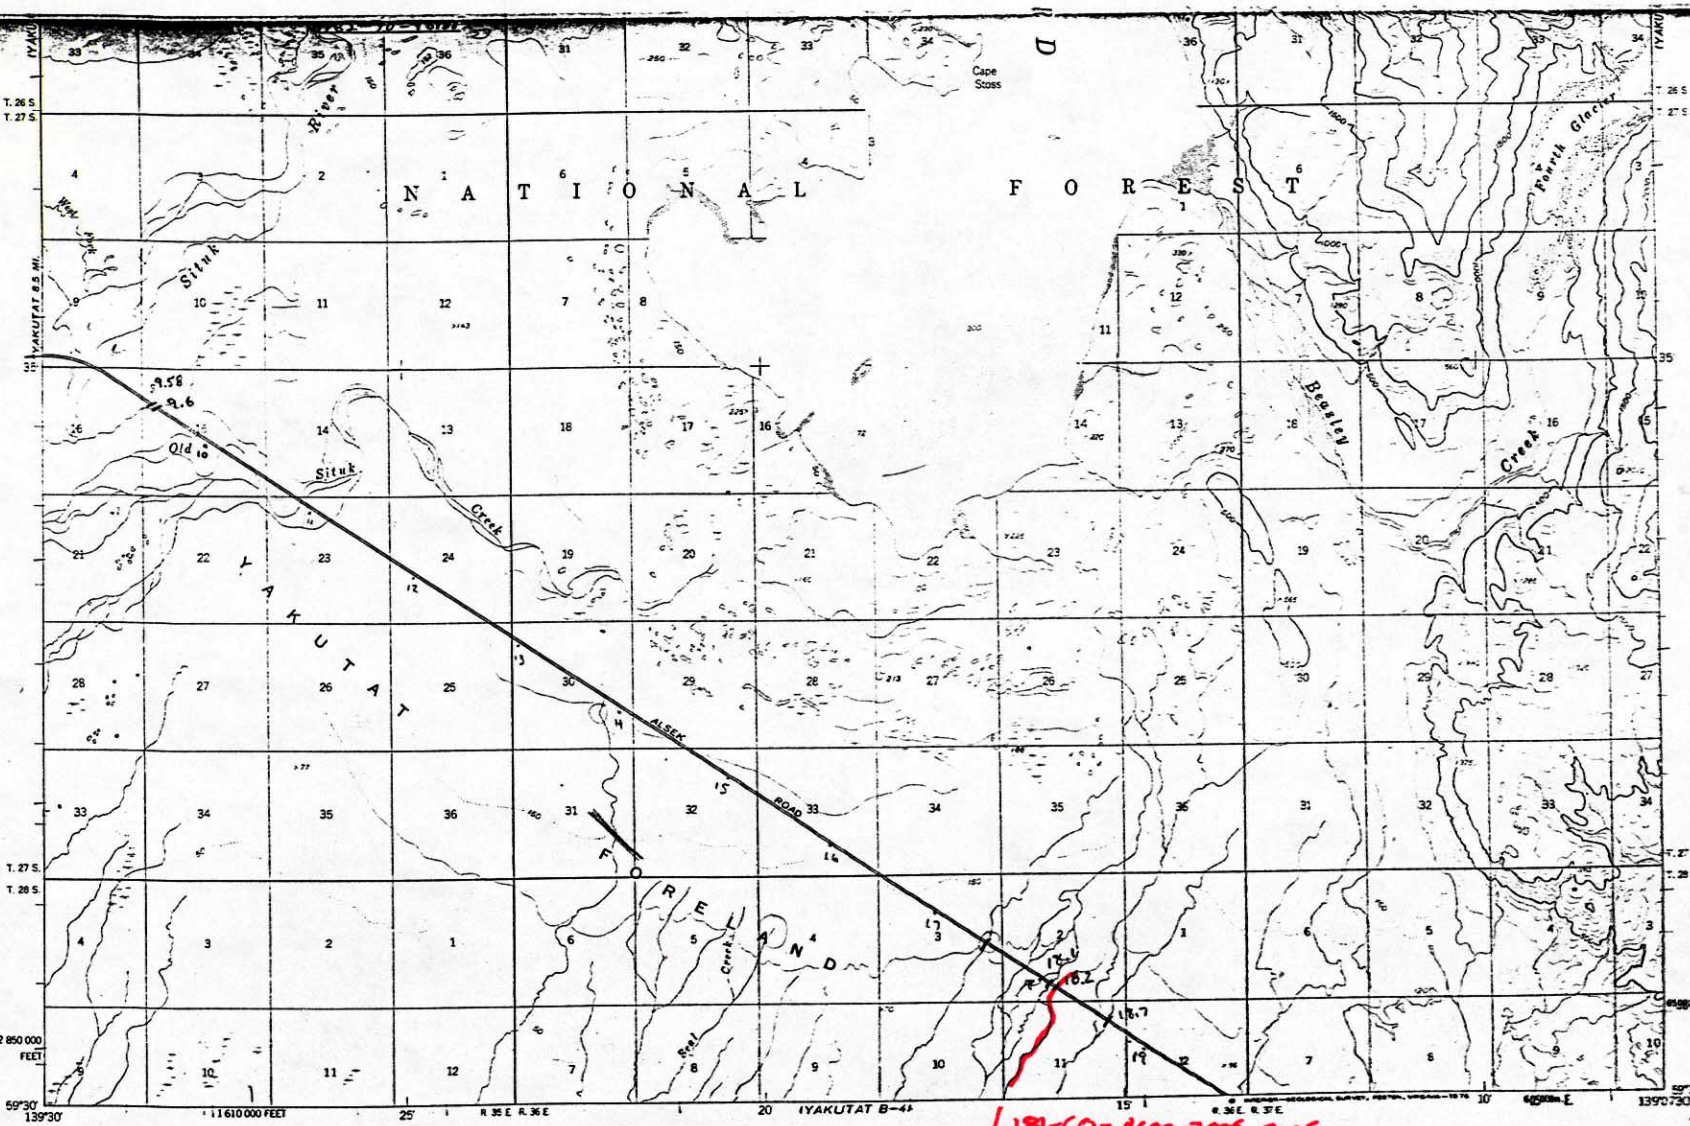

181-60-1600-2005, 3005

Mapped, edited, and published by the Geological Survey

Control by USGS

Topography by photogrammetric methods from aerial photographs taken 1948 and 1958, field annotated 1959. Map not field checked

Selected hydrographic data compiled from USC&GS Chart 8402 (1960), and from aerial photographs. This information is not intended for navigational purposes

Universal Transverse Mercator projection, 1927 North American datum. 10,000-foot grid based on Alaska coordinate system, zone 1. 1000-metre Universal Transverse Mercator grid ticks, zone 7, shown in blue

Land lines represent unsurveyed and unmarked locations predetermined by the Bureau of Land Management. Folio CR-8, Copper River Meridian

Swamps, as portrayed, indicate only the wetter areas, usually of low relief, as interpreted from aerial photographs

Lake elevations are unchecked

TRUE NORTH
MAGNETIC NORTH
29°
APPROXIMATE MEAN DECLINATION, 1959

SCALE 1:63360

CONTOUR INTERVAL 100 FEET
DOTTED LINES REPRESENT 50 FOOT CONTOURS
NATIONAL GEODETIC VERTICAL DATUM OF 1929
SOUNDINGS IN FEET. DATUM IS MEAN LOWER LOW WATER
SHORELINE SHOWN REPRESENTS THE APPROXIMATE LINE OF MEAN HIGH WATER
THE MEAN RANGE OF TIDE IS APPROXIMATELY 8 FEET

FOR SALE BY U. S. GEOLOGICAL SURVEY
FAIRBANKS, ALASKA 99701, DENVER, COLORADO 80225, OR RESTON, VIRGINIA 22092
A FOLDER DESCRIBING TOPOGRAPHIC MAPS AND SYMBOLS IS AVAILABLE ON REQUEST

ROAD CLASSIFICATION
Light-duty

QUADRANGLE LOCATION

YAKUTAT (C-4), ALASKA
N59°30'-N60°00' / 139°30'-137°00'

1959