State of Alaska
Department of Fish and Game
Nomination for Waters
Important to Anadromous Fish

FISH & GAME
OCT 13 1992
REGION II
HABITAT DIVISION

AWC Volume (SE) SC SW W AR IN USGS Quad Craig A-3

Anadromous Water Catalog Number of Waterway 103-25-10050-2015-3030

Name of Waterway trib. to N. Fk. Saltery Cr. USGS name ____ Local name ____

Addition X Deletion ____ Correction ____ Backup Information ____

For Office Use

Nomination # 93 066

Revision Year: ____

Revision to: Atlas ____ Catalog ____ Both X

Revision Code: A-2

Regional Supervisor: Lanal Shea Date: 10-9-92

Ed Weiss 12/15/92

Drafted: L. Drone Date: 12/31/92

OBSERVATION INFORMATION

Species	Date(s) Observed	Spawning	Rearing	Migration	Anadromous
coho salmon			X		Yes

Provide any clarifying information, including number of fish observed, location of fish survey data, etc. Attach a copy of the fish survey data, if available. Attach a copy of a map showing location of mouth and upper points of each species, specific stream reaches identified for spawning or rearing, locations of barriers, such as falls.

Comments:

Fry observed by Klukwan Forest Products, Inc.'s Al Hunter; see attached field notes.

Name of Observer (please print) James D. Durst, Habitat Biologist

Date: 10/5/92 Signature: James D Durst

Address: ADF&G Habitat Division
P.O. Box 271, Klawock, AK 99925

Signature of Area Biologist: Jack Gustafson

Rev. 12/91

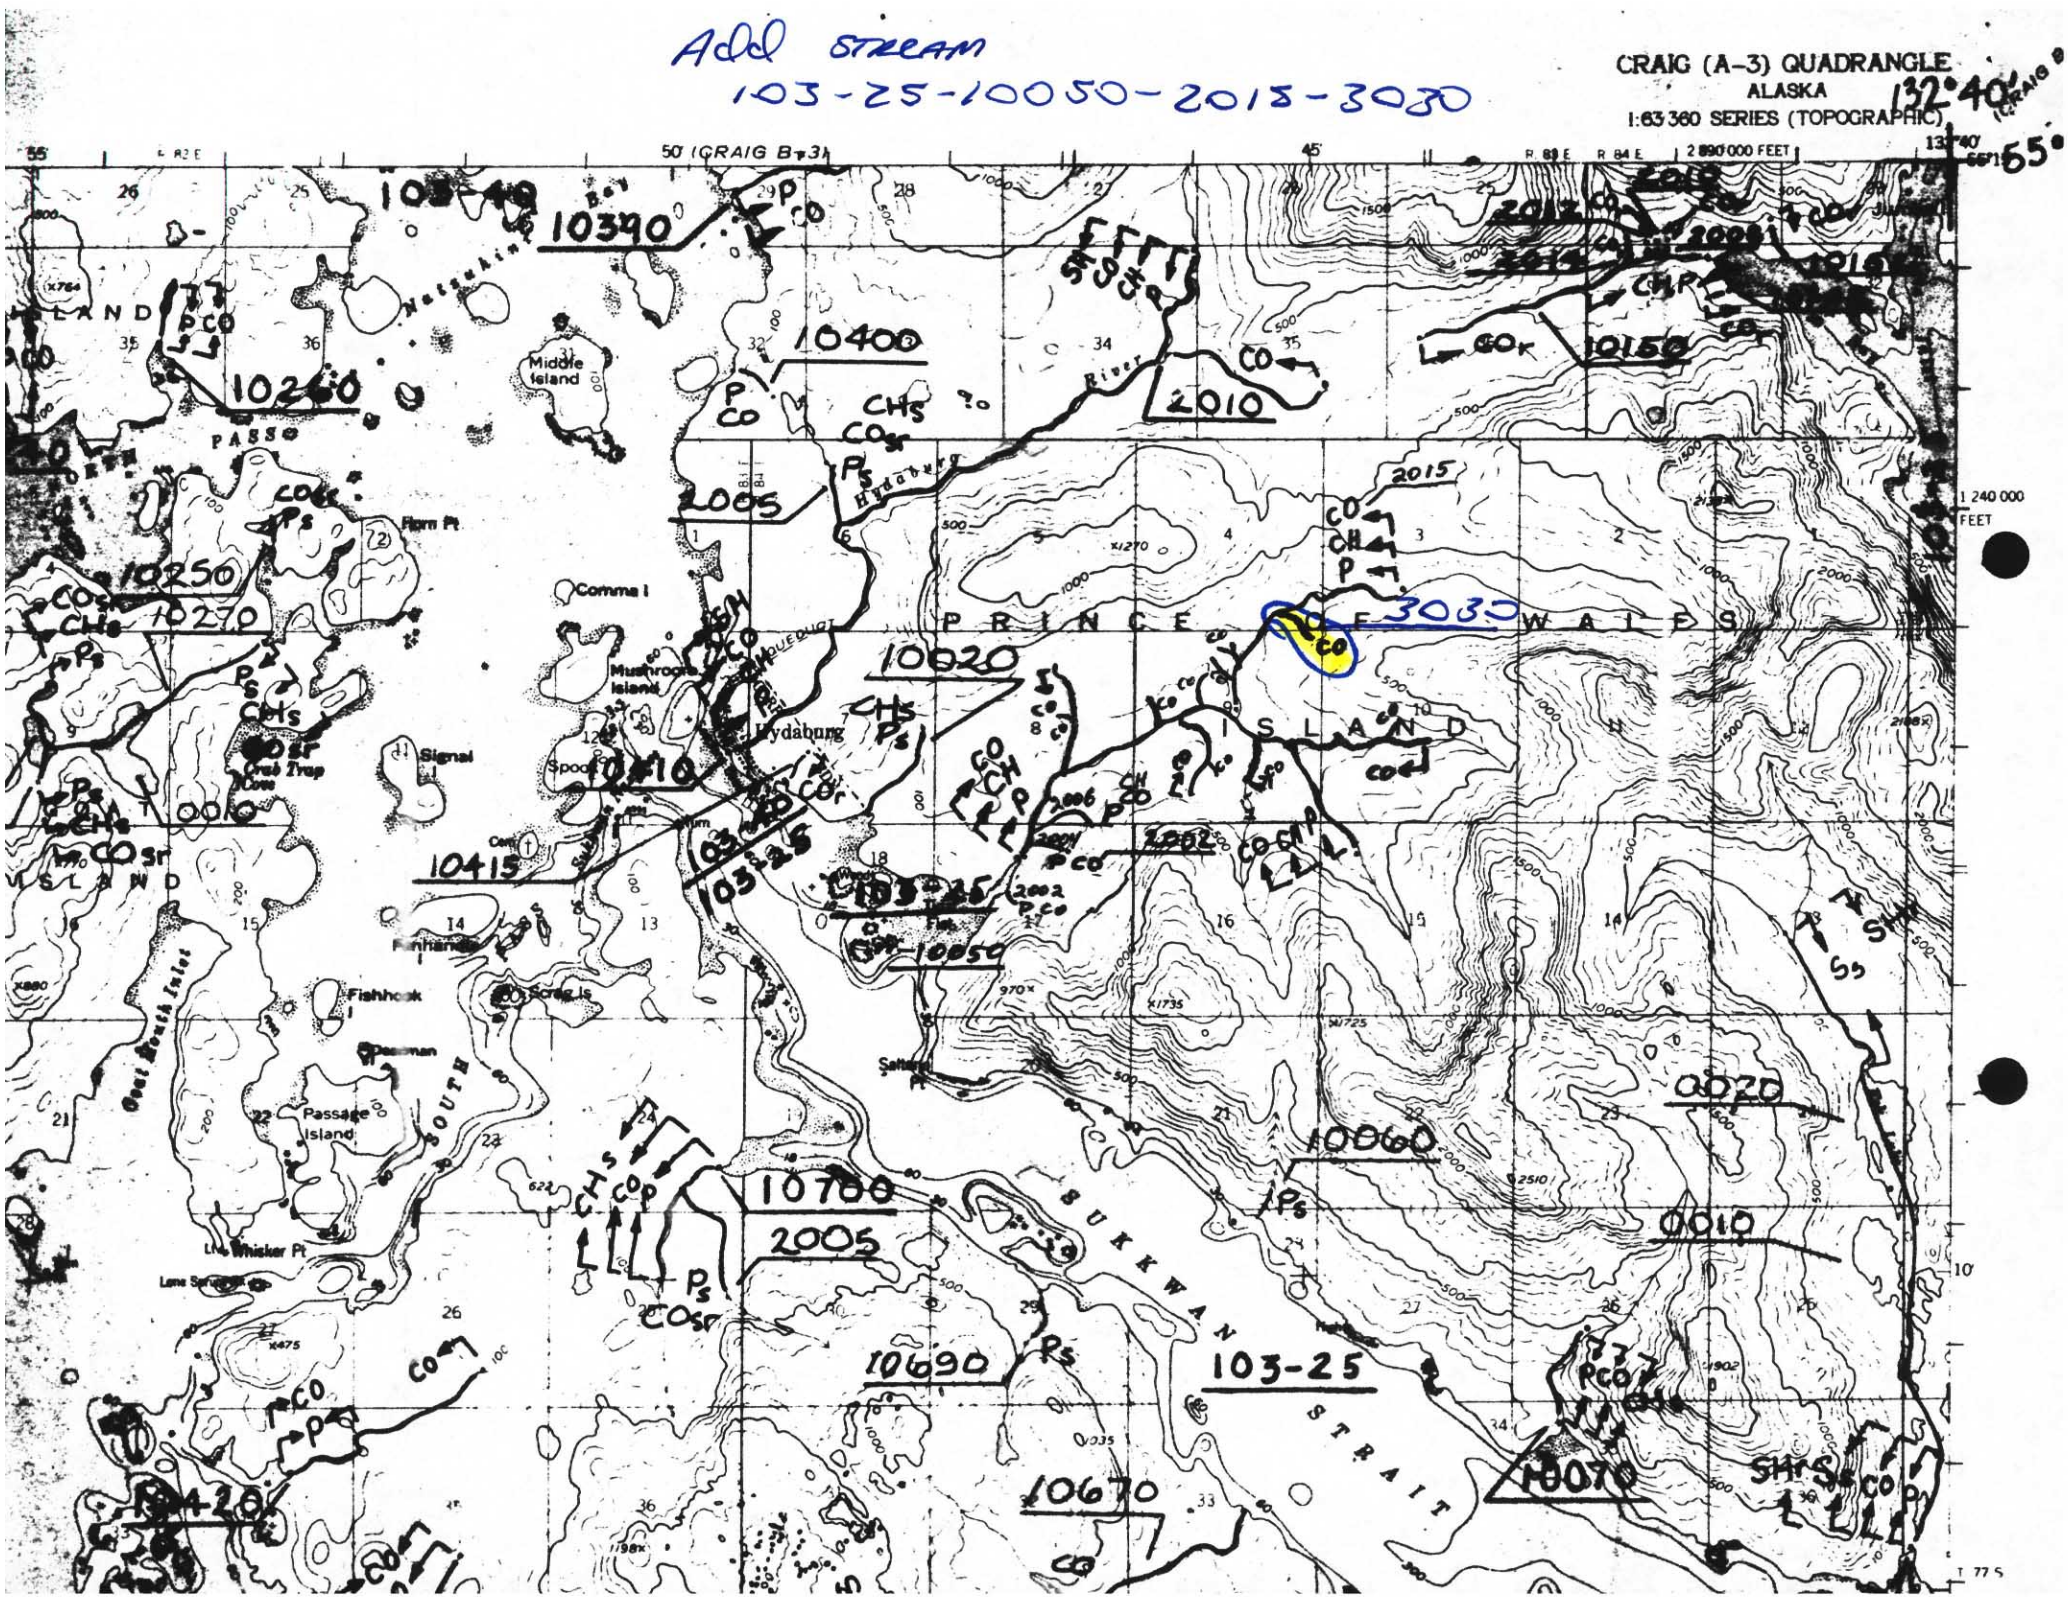
Add STREAM
103-25-10050-2015-3030
CRAIG (A-3) QUADRANGLE
ALASKA
1:63 360 SERIES (TOPOGRAPHIC)
132°40'
55°
50' (CRAIG B-3)
2 890 000 FEET
1 240 000 FEET
PRINCE OF WALES ISLAND
SUKKWAN STRAIT
Middle Island
Farm Pt
Comma I
Mushroom Island
Hydaburg
Signal
Spoon
Fishhook
Passage Island
Low Whisker Pt
10390
10400
10260
10250
10270
10020
10410
10415
10325
10050
10700
10690
10670
10420
10060
10070
2010
2015
2005
3030
2020
2010
2002
2006
2005
10150

KLUKWAN FOREST PRODUCTS, INC.
P.O. BOX 5960, KETCHIKAN, ALASKA 99901
OFFICE: (907) 225-2675 - FAX NO.: (907) 225-7521

RECEIVED
6/26/92
HABITAT
KLW

MEMORANDUM OF TRANSMITTAL

TO: Jim Durst

ADDRESS:

FAX NO.: 755-2440

FROM: Ellis Worthylake

DATE: 6/26/92

NUMBER OF PAGES (INCLUDING THIS PAGE) One

If you do not receive all pages or experience any problems in the transmittal, please call Ellis at the above number.

Hello Jim!

Well, we found a surprise on the 100 Rd system at approximate sta. 32+00; a little tributary to N. Fork Salt Lg Cr. That appears to have two types of fish. A/ Hunter believes There one coho; I saw fish Today with dark spots on light background, coho right?

Any way Jim this was certainly overlooked. It is in a muskeg and if you didn't step into it you wouldn't. Know it was There. This is 2000'± ~~from~~ east of the bridge Xing.

We have already cut the R/W Through This area; no Timber to speak of. The road subgrade should be to this creek on July 8th±. We would like to go ahead and put puncheon down on either side of the creek and continue the subgrading then when the surfacing gets There, put The ~~36"~~ 30" x 30±' Culvert in and continue on. I really can not see where we would disturb The area except when we have to make a straight lay for the culvert.

Please call me at The office on 6/27 between 6:30 to 12 or at home This evening or Sat-Sun. Ph. 225-7044- Thanks Ellis

06-26-92 FRI 15:51 P.01

22 July (cont.)

100 Road crossing:

stopped at culvert at 32+00; stream 1-2' wide in 2'-3' deep slot through muskeg; organic bottom; good flow; culvert installation OK, but could have been bedded deeper; should pass fish;

stopped at culvert at 35+50; low flow; culvert less than expected; looks marginal for fish pass if needed

drove to fork at 250 spur & left track; walked to a bit beyond, mostly to end of 100 Road; at 240 short left trail & downhill to Salmon River. Some falls; gravel & trap; some bouldery, boggy & disturbed; RFP's 5/14/92 flagging, mostly up small

22 July (cont.)

trib from N to river end of rd. flow, above RFP says upper end anad; dace; CO fry seen in pools, but trapped some anyway;

trib: upper end OHW 2'-5' wide, 1' x ; flow presently ~ ½ of OHW; gravel, 30 chains W of E power line; 3% - 10%; silty bottom

trib: 10 CO, 3 DV (RFP had >50 CO above this) CO seen in pools

near mouth, high water channel from Salmon R. trib 5'-10' at mouth; looks good Type 3 fish trib & Salmon R. at mouth

State of Alaska
Department of Fish and Game
Nomination for Waters
Important to Anadromous Fish

ALASKA DEPT. OF
FISH & GAME

OCT 13 1992

REGION II
HABITAT DIVISION

AWC Volume (SE) SC SW W AR IN USGS Quad Craig A-3

Anadromous Water Catalog Number of Waterway 103-25-10050 - various

Name of Waterway Saltery Creek System USGS name ___ Local name ___

Addition X Deletion ___ Correction ___ Backup Information ___

For Office Use

Nomination # 93 055	Tamal Shea — Regional Supervisor — 10-9-92 Date
Revision Year: ___	___ ___
Revision to: Atlas ___ Catalog ___ Both ___	___ ___
Revision Code: ___	Drafted — Date

OBSERVATION INFORMATION

See attachments

Species	Date(s) Observed	Spawning	Rearing	Migration	Anadromous

Provide any clarifying information, including number of fish observed, location of fish survey data, etc. Attach a copy of the fish survey data, if available. Attach a copy of a map showing location of mouth and upper points of each species, specific stream reaches identified for spawning or rearing, locations of barriers, such as falls.

Comments:

Extensive baited minnow trapping and fry observation during several Forest Practices Inspections. See attached sheets for details.

Name of Observer (please print) James D. Durst, Habitat Biologist

Date: 10/6/92 Signature: James D Durst

Address: ADF&G Habitat Division
P.O. Box 271, Klawock, AK 99925

Signature of Area Biologist: Jack Anderson

Rev. 12/91

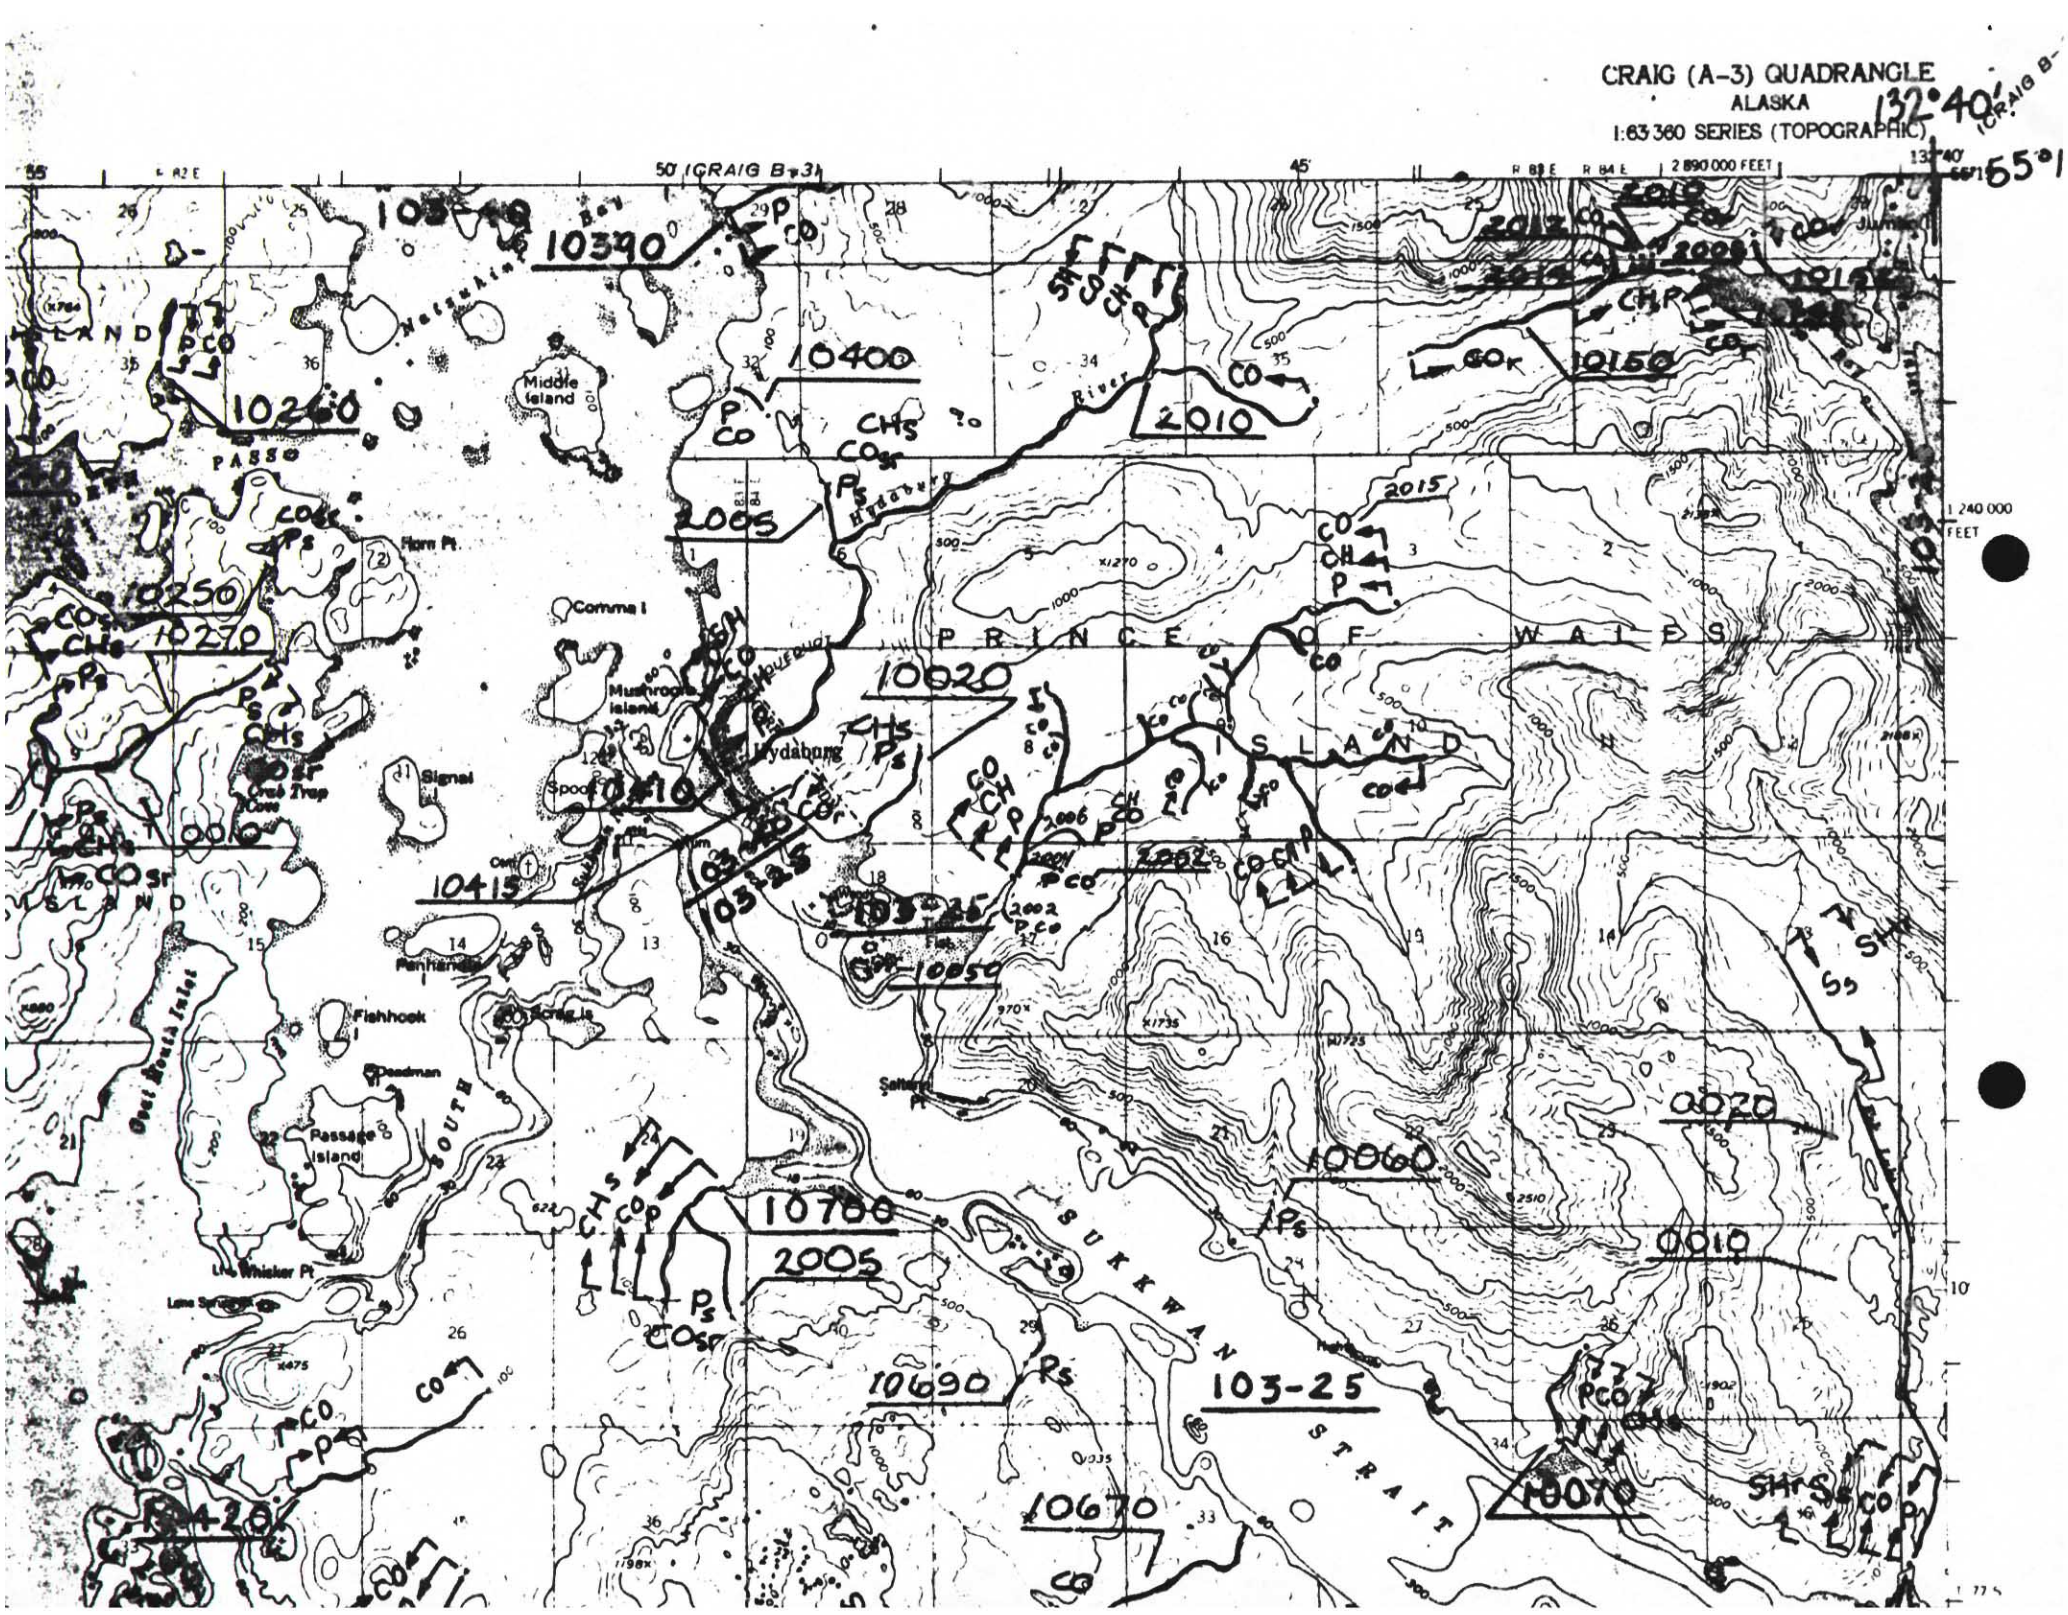
CRAIG (A-3) QUADRANGLE
ALASKA
1:63 360 SERIES (TOPOGRAPHIC)
132°40'
55°1
50' (CRAIG B-3)
45'
2 890 000 FEET
1 240 000 FEET
PRINCE OF WALES ISLAND
Middle Island
Comma I
Mushroom Island
Hydaburg
Signal I
Fishhook
Deadman
Passage Island
Low Whisker Pt
Low Spit
Farm Pt
Penlatch
Sukkwan Island
SUKKWAN STRAIT
PASSO
10390
10400
10260
10250
10270
10020
10410
10415
10325
10850
10700
10690
10670
10420
10060
10070
2010
2015
2005
2002
2006
2012
2008
2020
0010
0020
0030
10150
10100

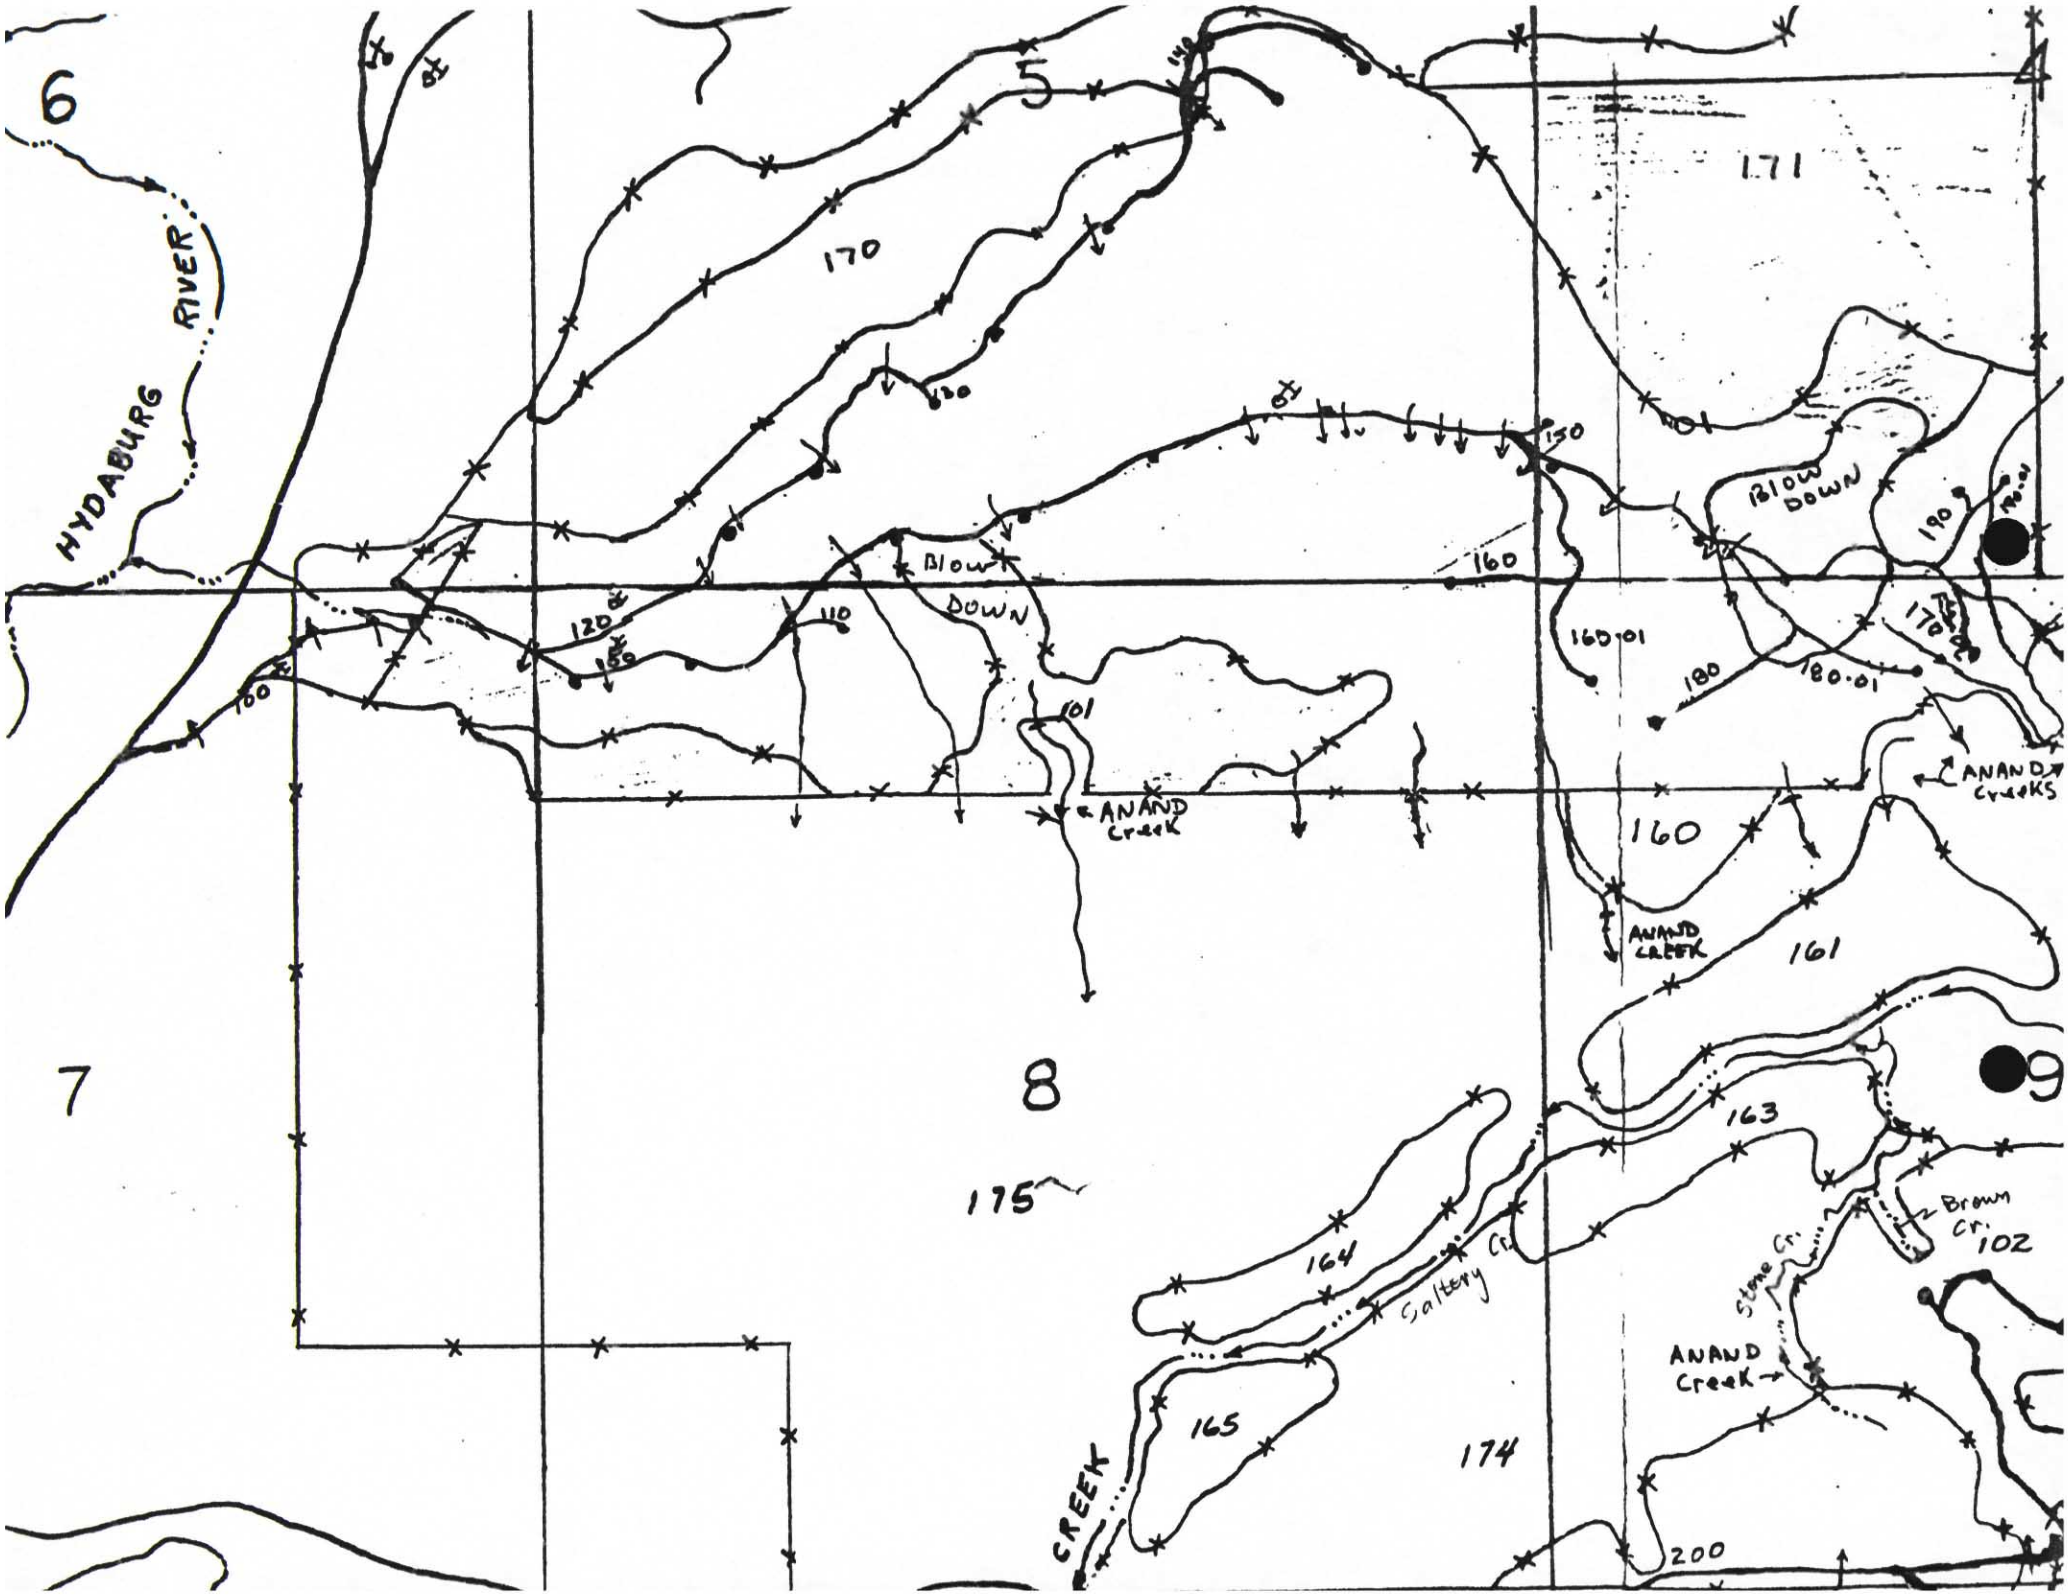
6
5
171
HYDABURG RIVER
170
120
130
150
BLOW DOWN
190
160
110
160.01
180
180.01
170
165
100
101
ANAND Creek
ANAND Creeks
160
ANAND CREEK
161
7
8
9
175
163
164
Saltery Cr.
Brown Cr.
102
Stone Cr.
ANAND Creek
165
174
CREEK
200

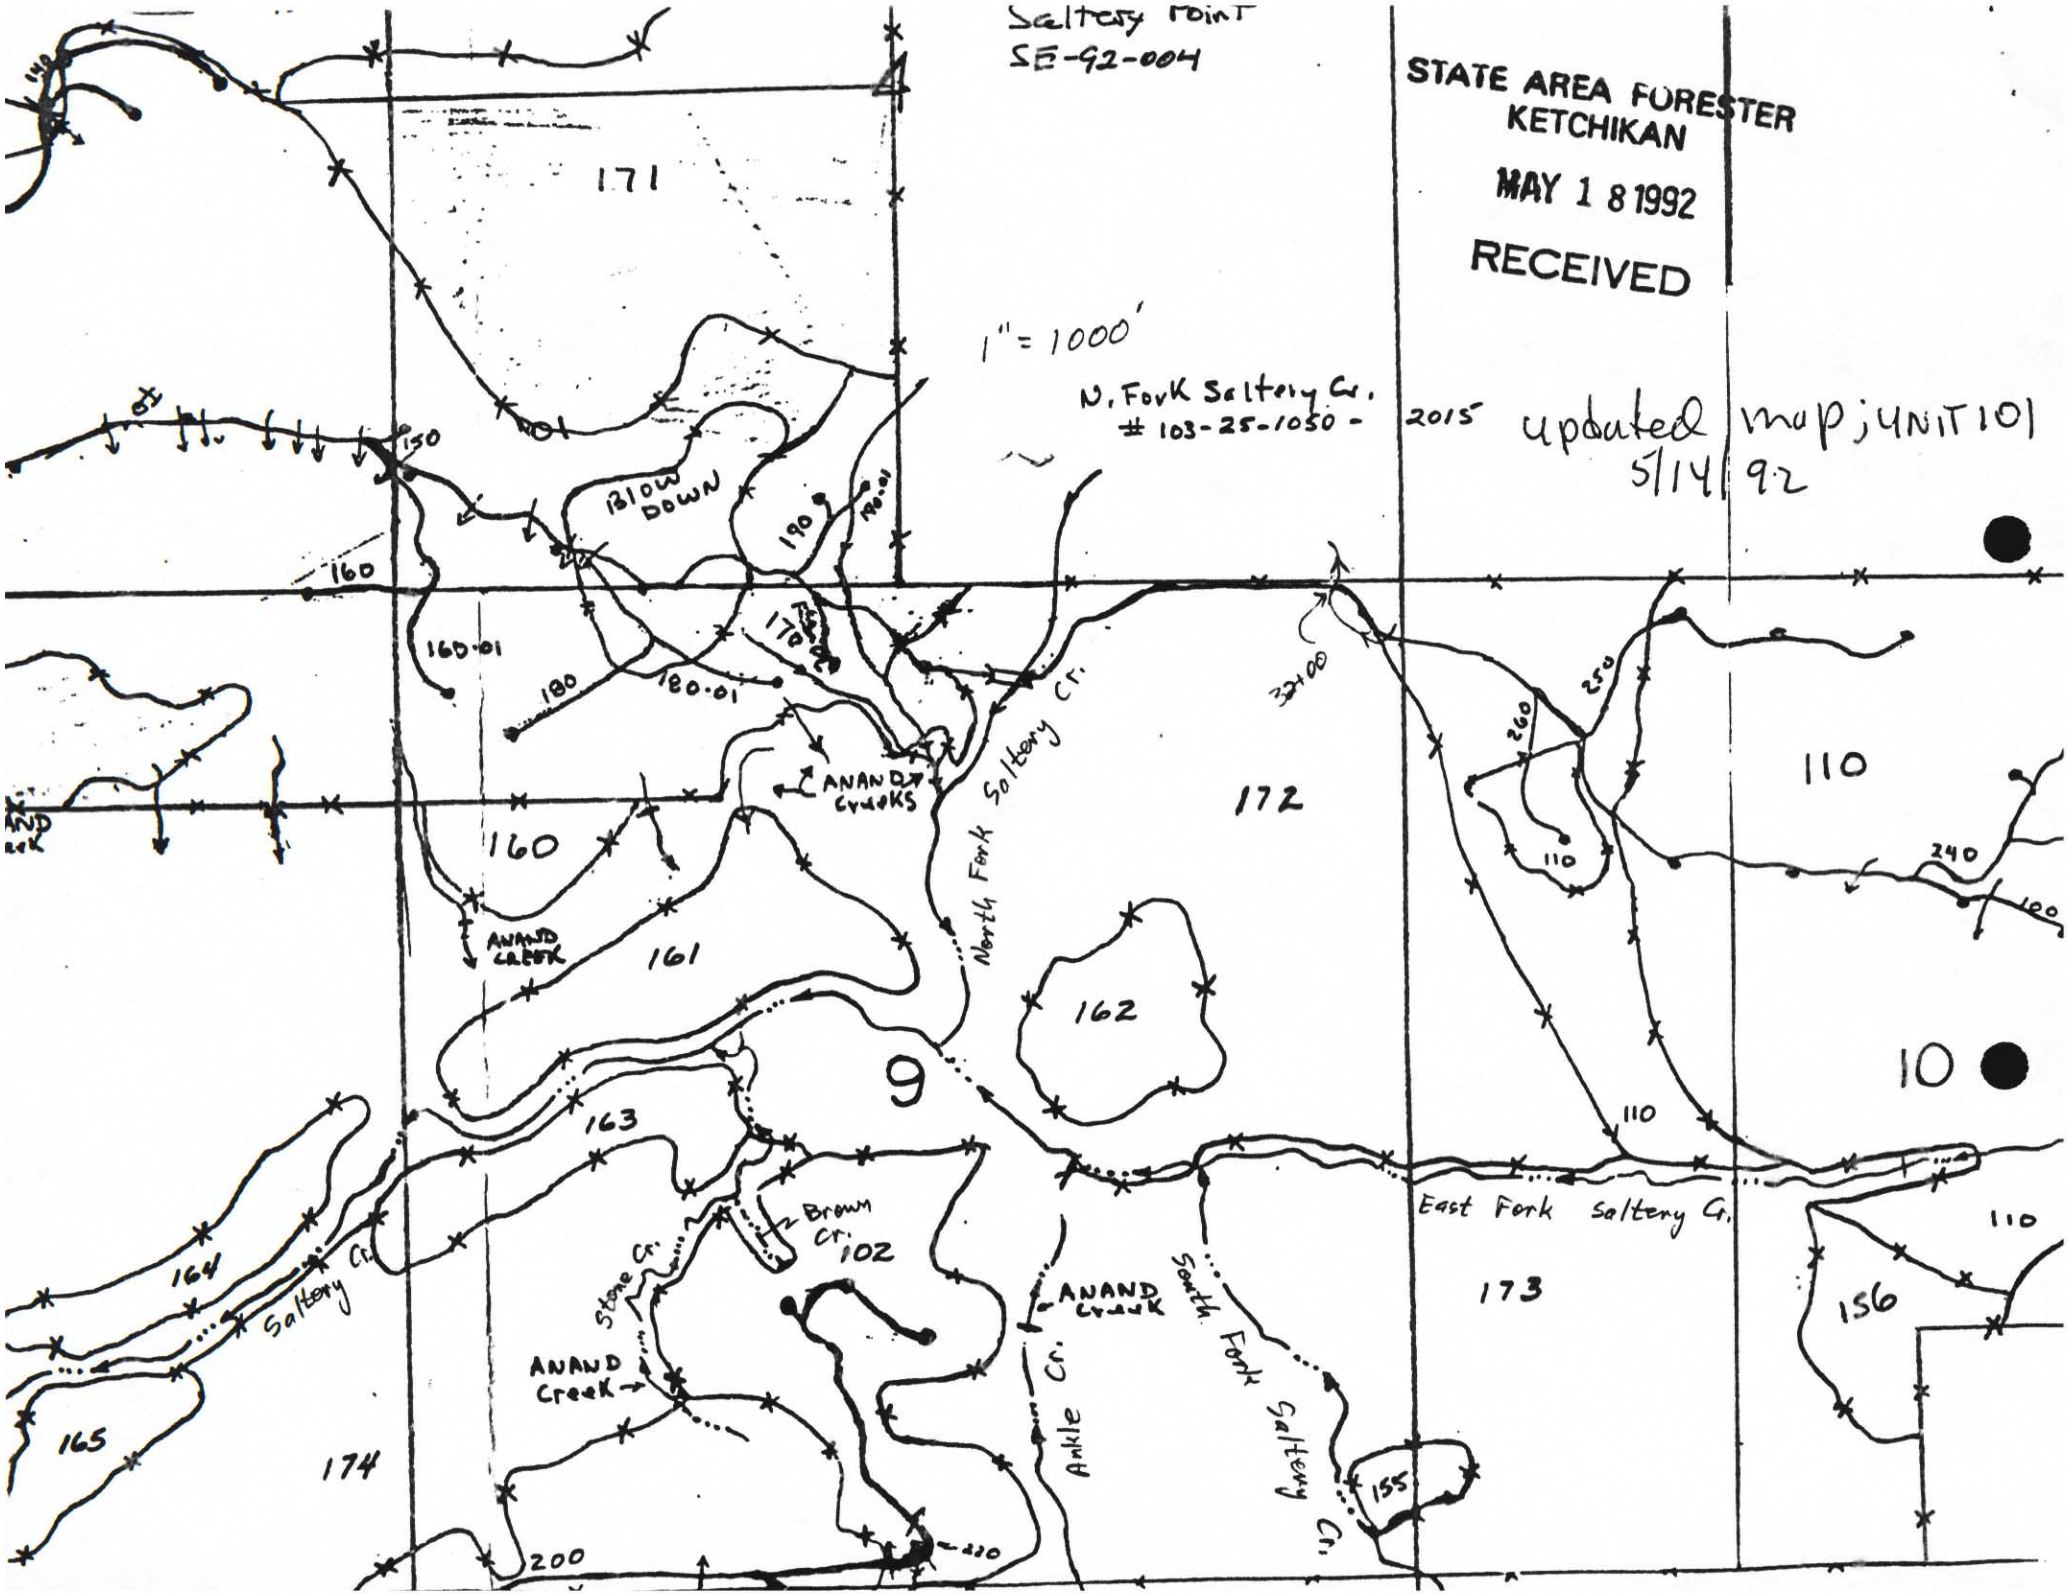
Saltery Point
SE-92-004
STATE AREA FORESTER
KETCHIKAN
MAY 1 8 1992
RECEIVED
1" = 1000'
N. Fork Saltery Cr.
103-25-1050 -
2015
updated map; UNIT 101
5/14/92
171
172
173
174
160
161
162
163
164
165
9
10
110
102
156
155
200
150
160-01
180
180-01
190
190-01
170
250
260
240
100
ANAND Creeks
ANAND Creek
North Fork Saltery Cr.
East Fork Saltery Cr.
South Fork Saltery Cr.
Saltery Cr.
Brown Cr.
Stone Cr.
Ankle Cr.
BLOW DOWN

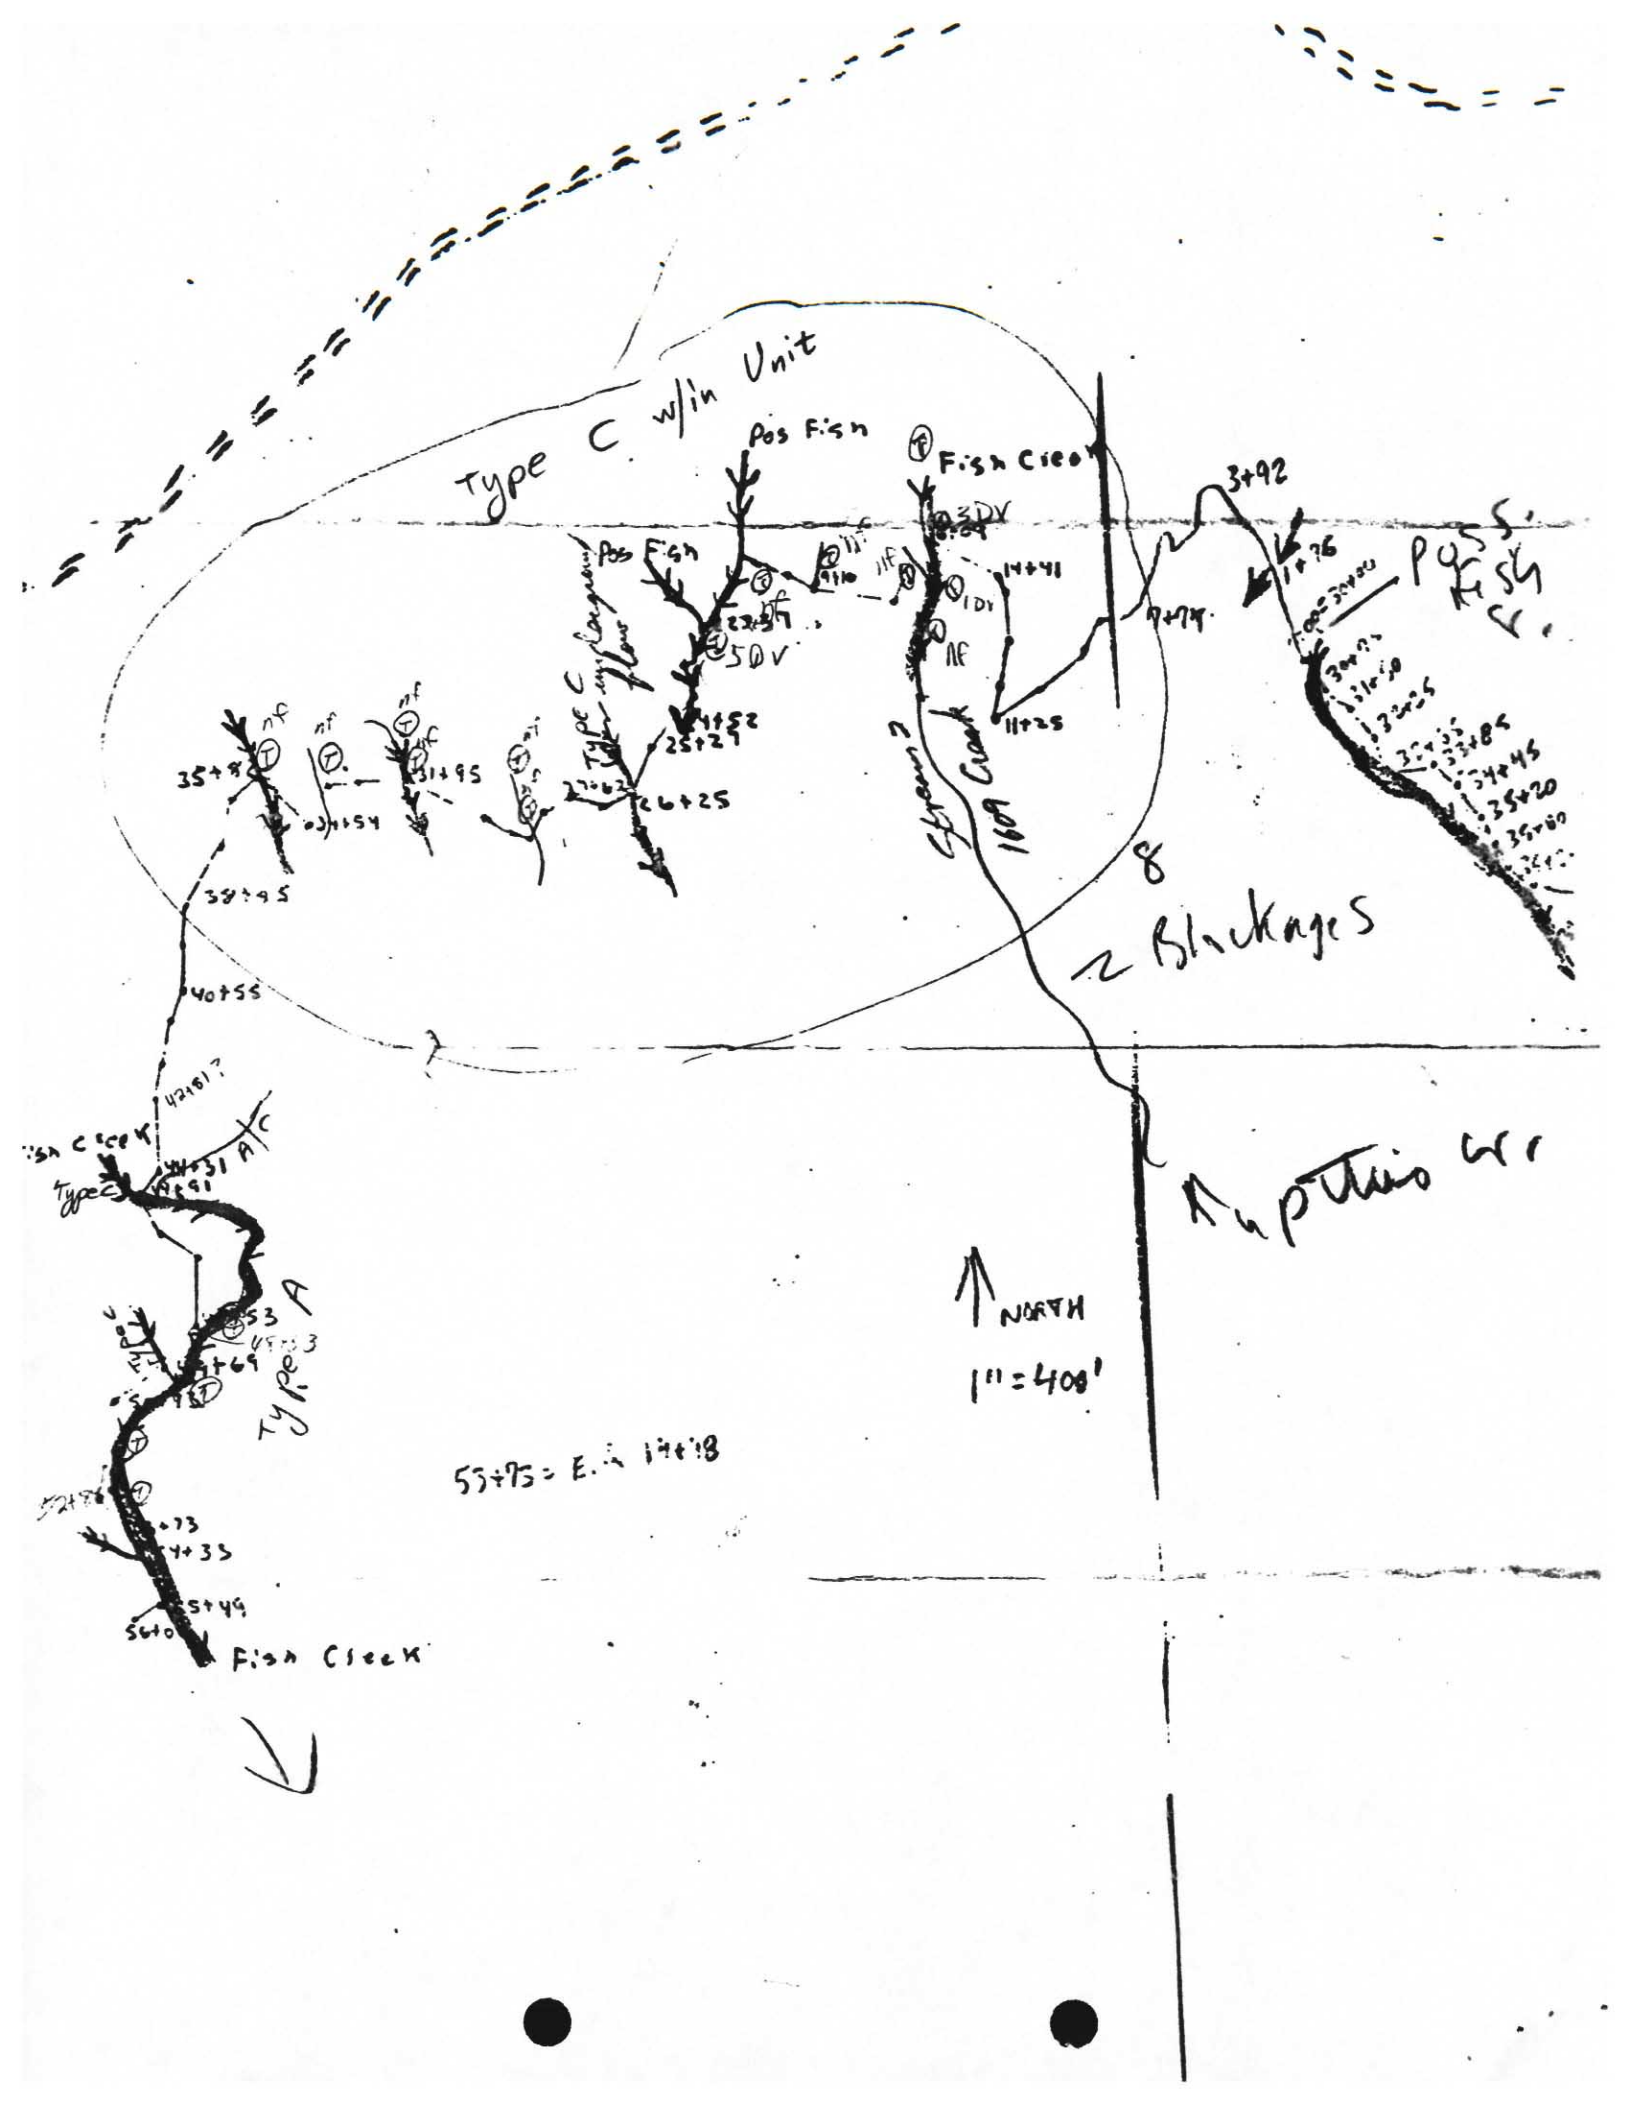
Type C w/in Unit
Pos Fish
Fish Creek
3+92
Pos Fish
Stream 2
1609 Creek
8
2 Blockages
Type C w/in Unit
Type A
NORTH
1" = 408'
55+75 = E.
Fish Creek

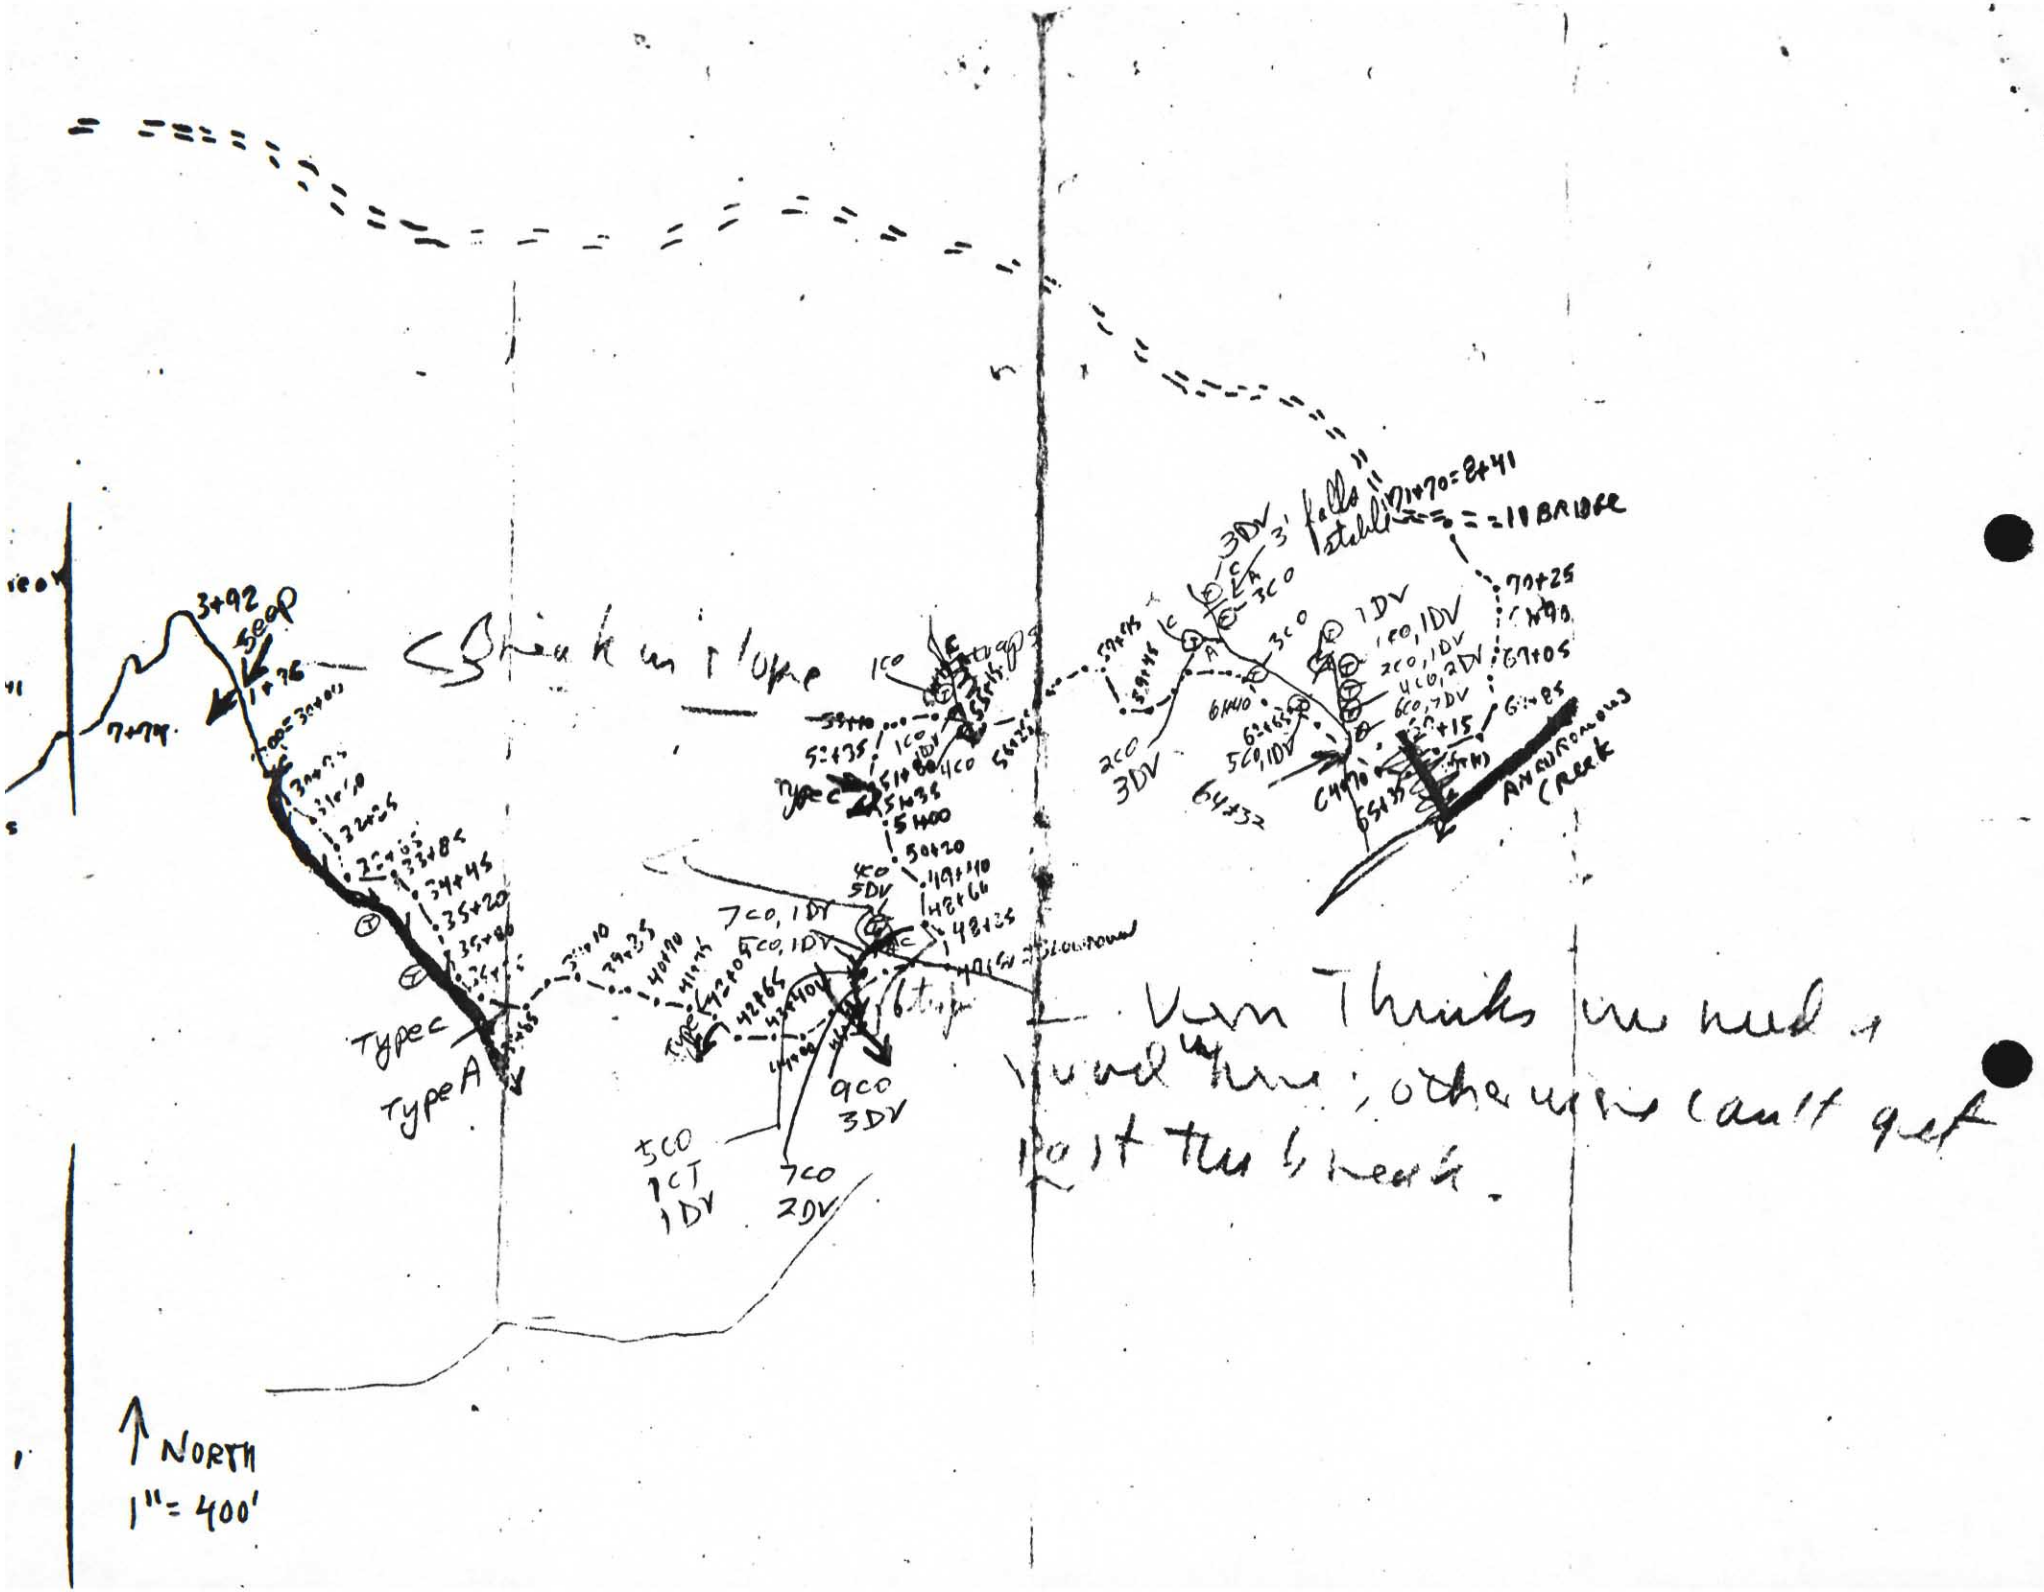
3+92
seep
Typec
TypeA
Falls stable
BRIDGE
NORTH
1"= 400'