State of Alaska
Department of Fish and Game
Nomination for Waters
Important to Anadromous Fish

AWC Volume (SE) SC SW W AR IN USGS Quad BERING GLACIER A-3 & A-4

Anadromous Water Catalog Number of Waterway WHITE RIVER 191-20-11000-2055

Name of Waterway WHITE RIVER TRIBUTARIES USGS name X Local name ___

Addition X Deletion ___ Correction X Backup Information X

For Office Use

Nomination # 93 304

Revision Year: ___

Revision to: Atlas ___ Catalog ___ Both X

Revision Code: A-Z

Regional Supervisor — Date 10-23-92

E D Weiss — 12/16/92

D. Grove — Drafted — Date 1/8/93

OBSERVATION INFORMATION

Species	Date(s) Observed	Spawning	Rearing	Migration	Anadromous
Coho	8/15/92		X		X

Provide any clarifying information, including number of fish observed, location of f survey data, etc. Attach a copy of the fish survey data, if available. Attach a copy o map showing location of mouth and upper points of each species, specific stream reac identified for spawning or rearing, locations of barriers, such as falls.

Comments:

DAVE HARDY AND I conducted stream surveys along the White River in August. These were foot surveys of streams to identify the extent of fish habitat. Those streams as shown on the map are clear-water tributaries of the White River. Correct #3011 to show the stream's correct location. Coho fry found to the base of Brower Ridge (Sec. 22; NE¼ of the SE¼). The tributary located in the NW¼ of the NW¼ Sec. 26 splits with one fork heading northward into beaver ponds and provides extensive coho rearing. Coho adults were found in this tributary last year.

Name of Observer (please print) PHIL MOONEY

Date: 10/16/92 Signature: Phil Mooney

Address:

State of Alaska
~~Department of Fish & Game~~
304 Lake Street, Room 103
~~Sitka, AK 99835-7563~~

ALASKA DEPT. FISH & GAME
OCT 26 199
REGION II
HABITAT DIVIS

Signature of Area Biologist:

Rev. 1

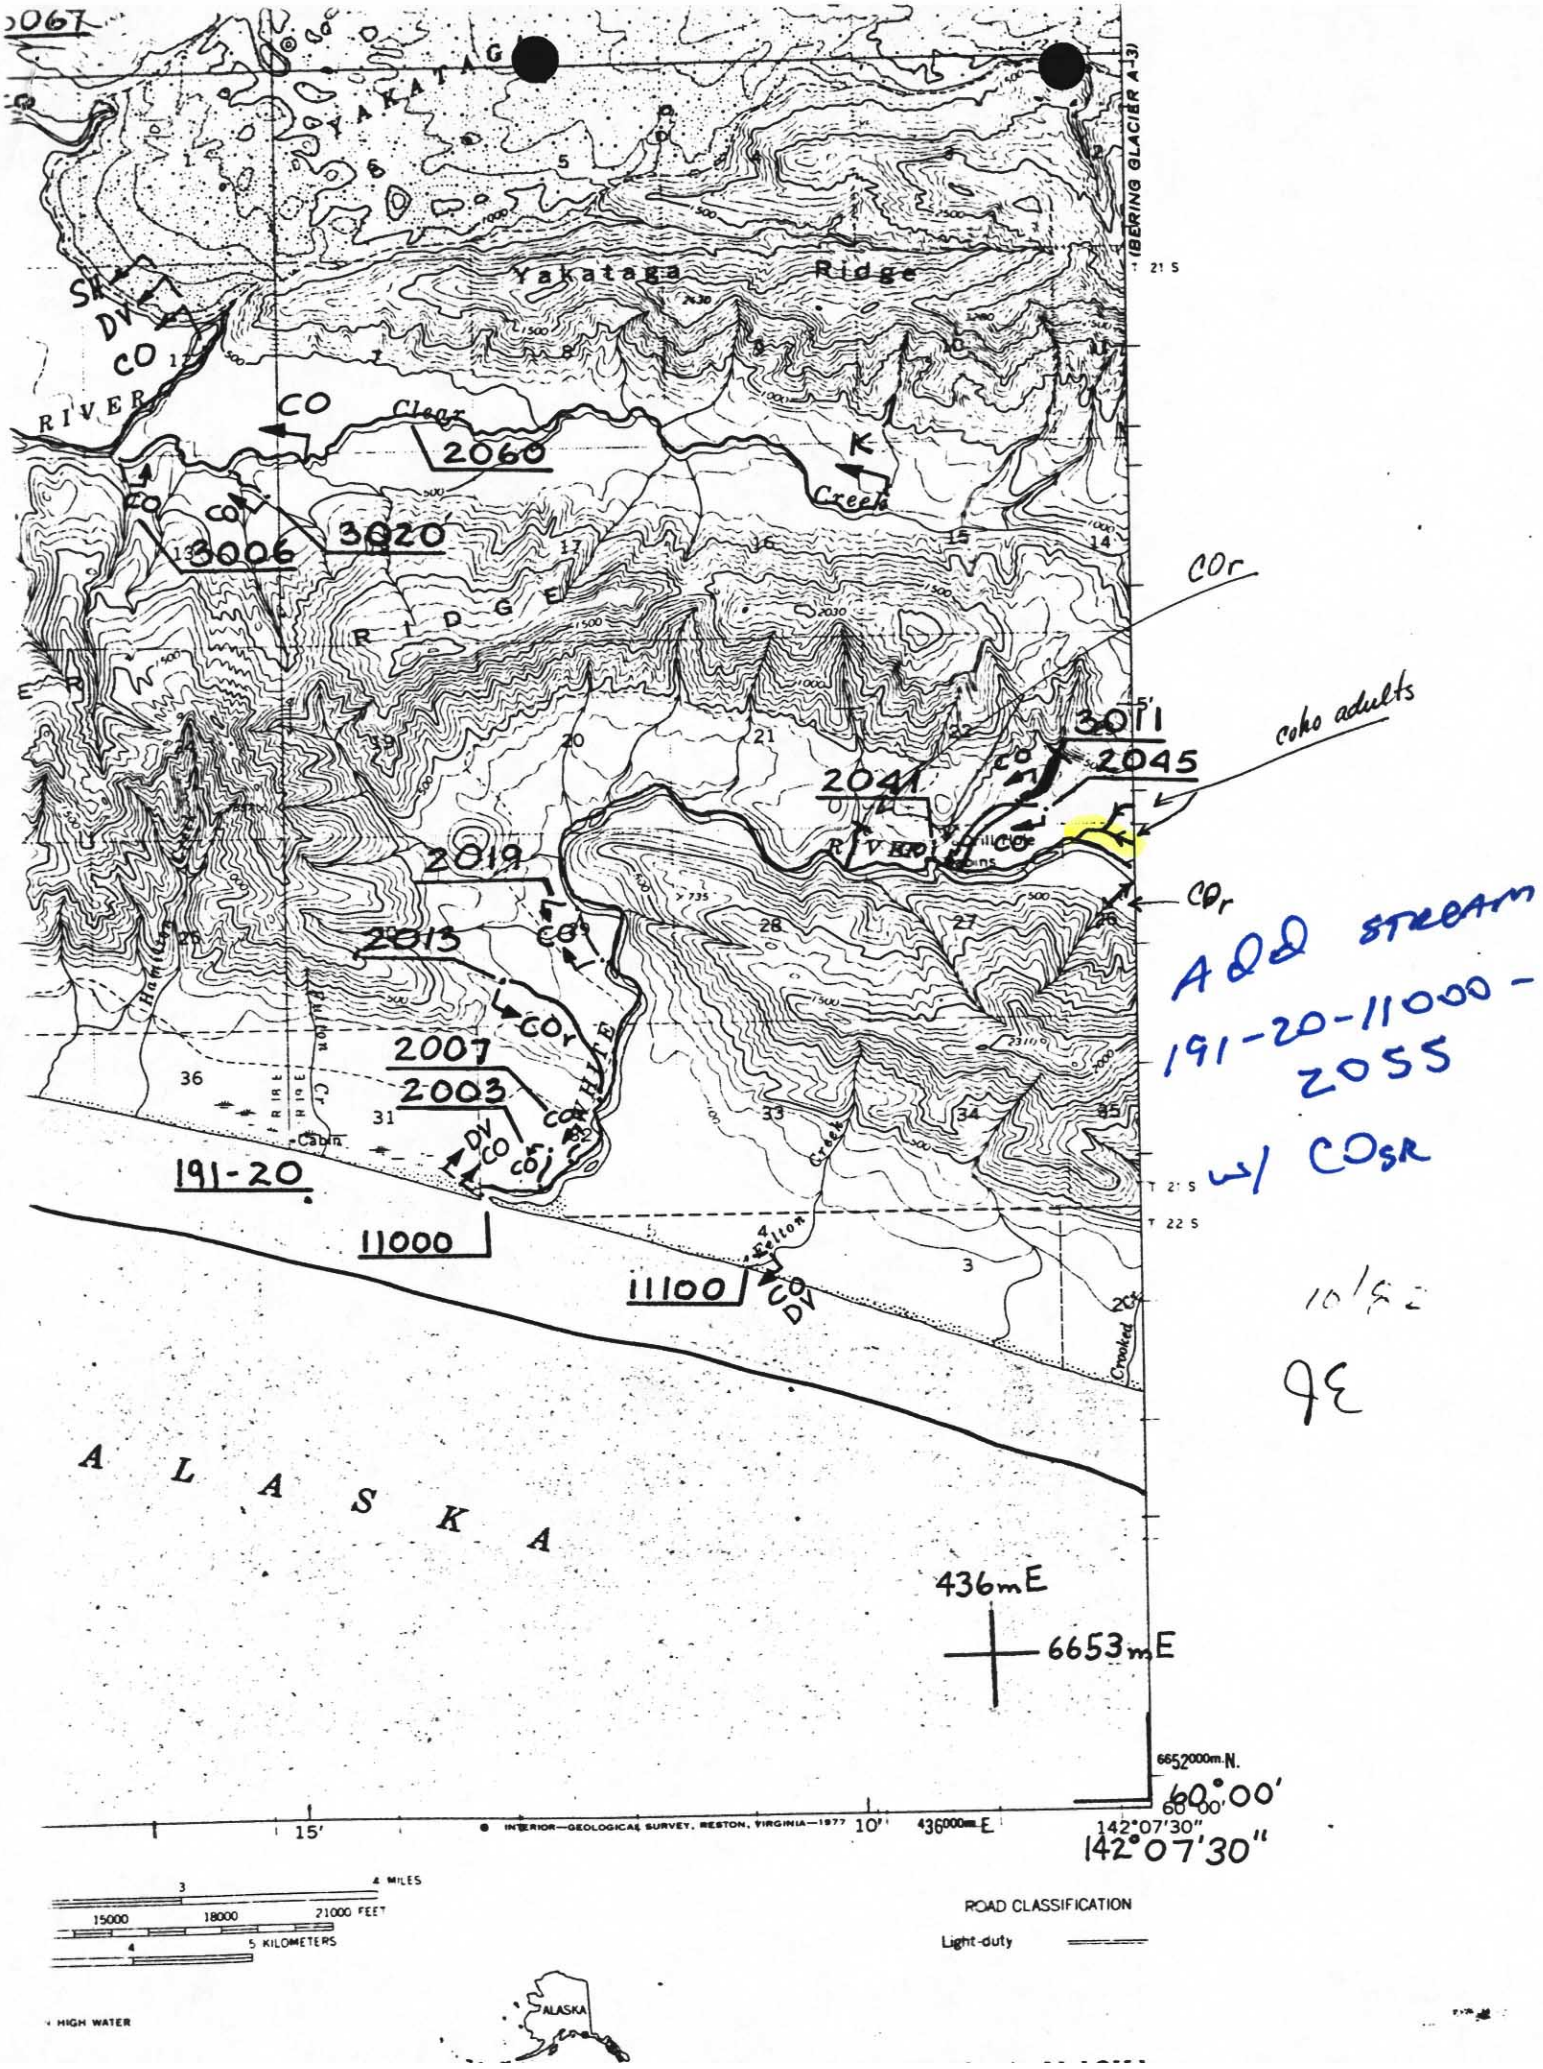
3067
YAKATAGA
Yakataga Ridge
RIVER
Clear
Creek
2060
3006
3020
RIDGE
2041
3011
2045
coho adults
2019
2013
2007
2003
Cabin
191-20
11000
11100
Crooked Creek
ALASKA
436mE
6653mE
6652000m N.
60°00'
142°07'30"
436000m E
15'
10'
INTERIOR—GEOLOGICAL SURVEY, RESTON, VIRGINIA—1977
ROAD CLASSIFICATION
Light-duty
ALASKA
HIGH WATER
ADD STREAM
191-20-11000-
2055
w/ COSR
10/92
9E

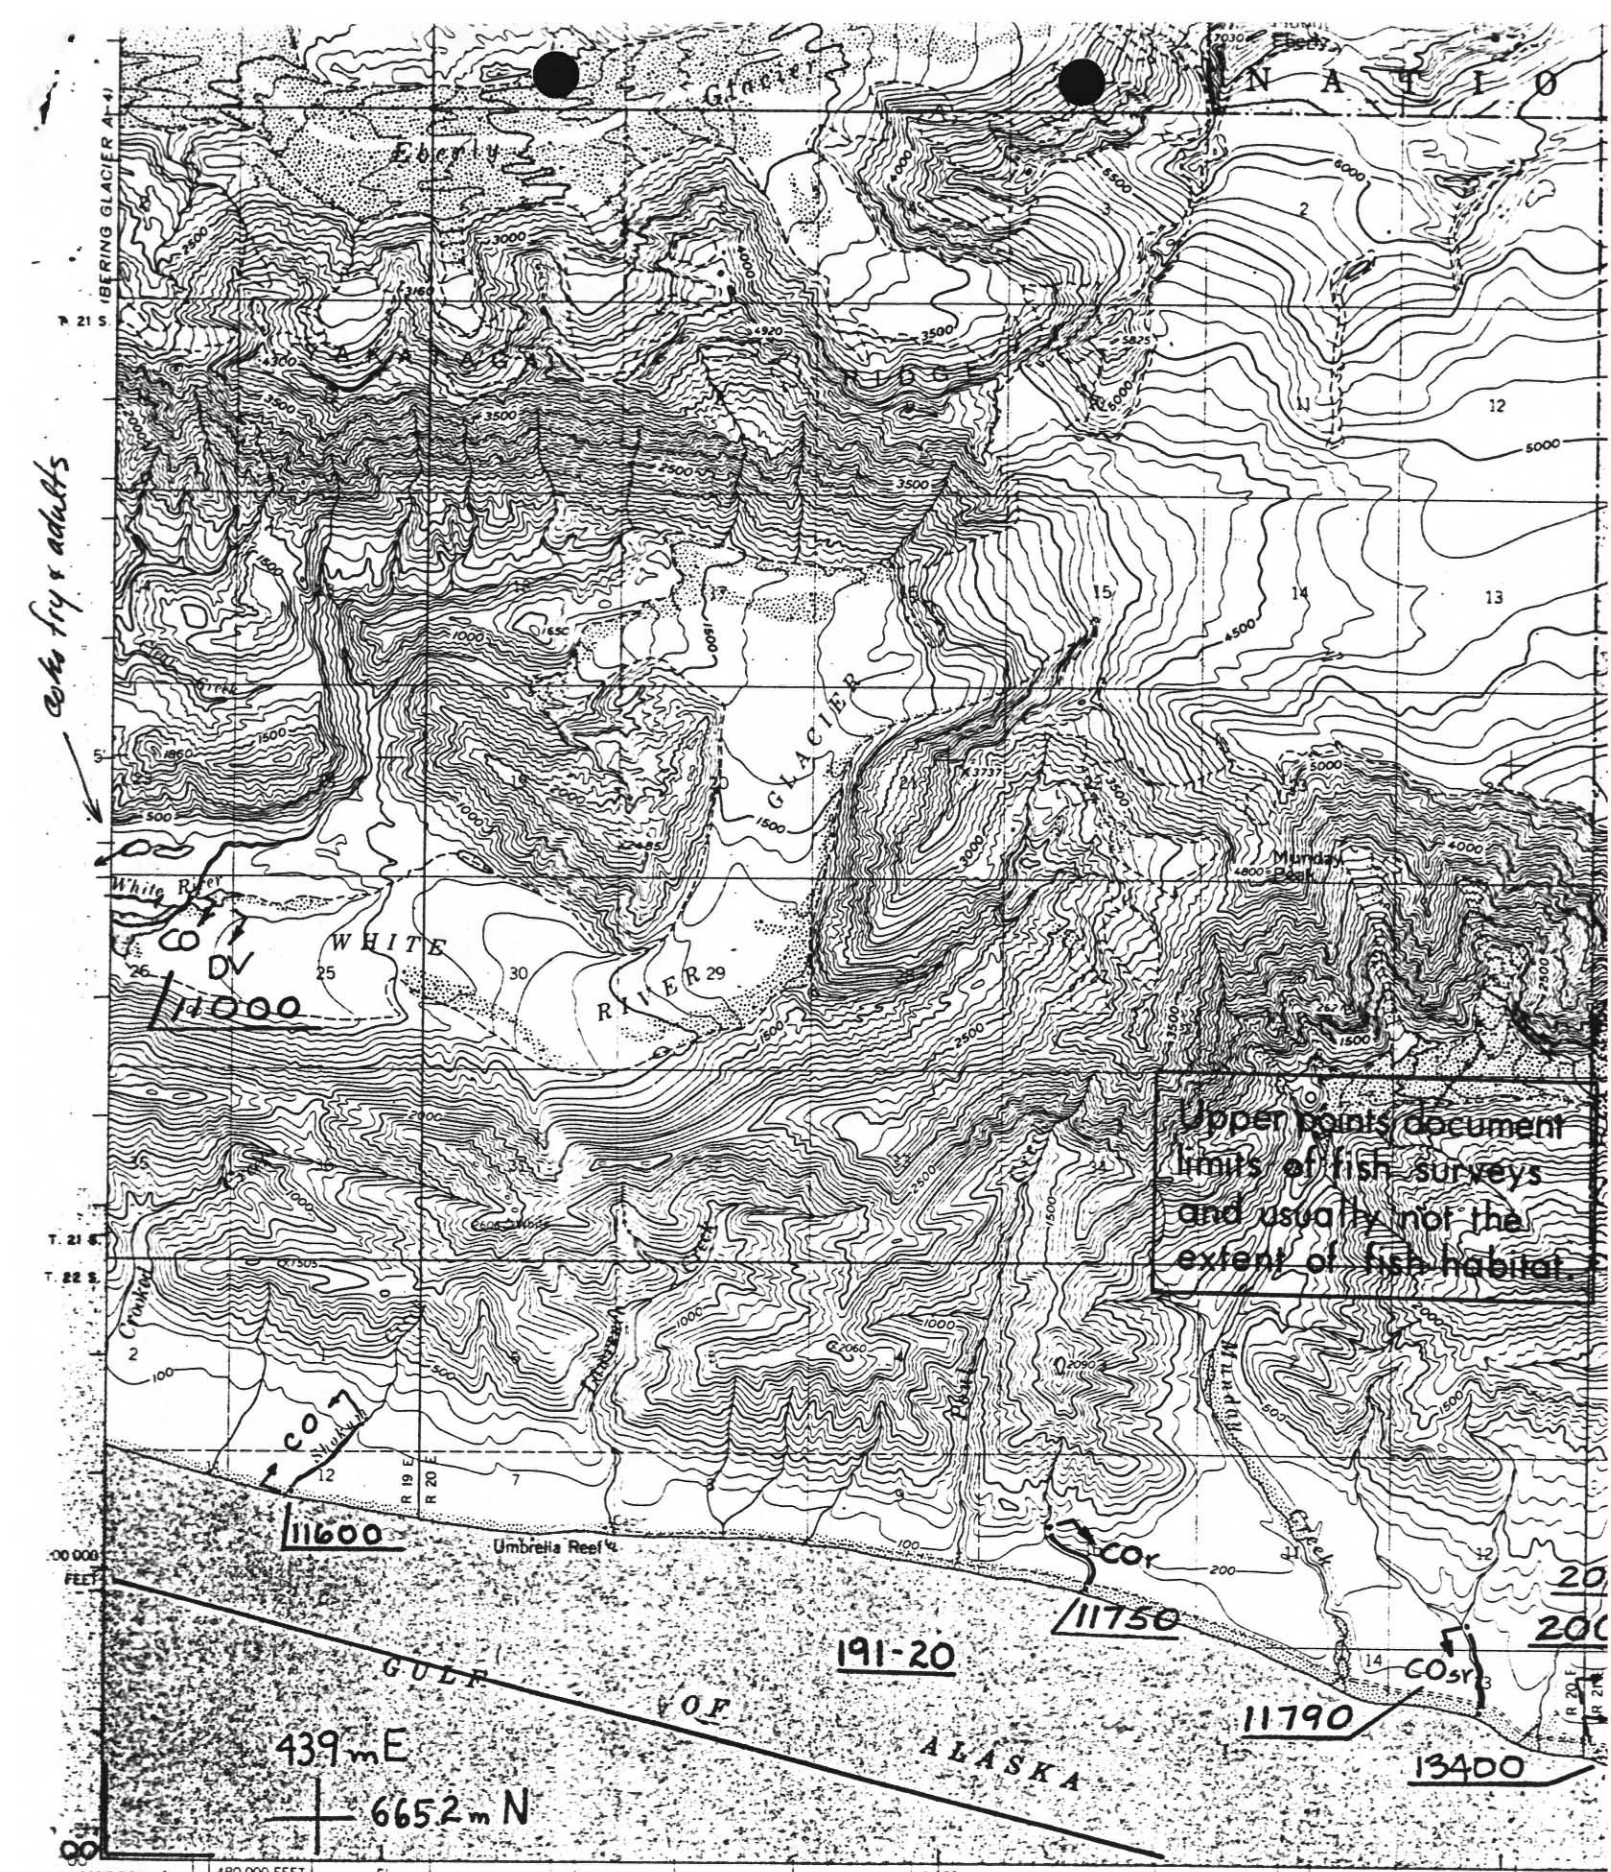
Eberly Glacier
BERING GLACIER
WHITE RIVER
GLACIER
Munday Peak
White River
Crooked Creek
Umbrella Reef
GULF OF ALASKA
Upper points document limits of fish surveys and usually not the extent of fish habitat.
11000
11600
11750
11790
13400
191-20
439 mE
6652 m N
42°07'30"
142°
SCALE 1:63360
CONTOUR INTERVAL 100 FEET
NATIONAL GEODETIC VERTICAL DATUM OF 1929
SHORELINE SHOWN REPRESENTS THE APPROXIMATE LINE OF MEAN HIGH WATER
Mapped, edited, and published by the Geological Survey
Control by USGS and USC&GS
Topography by photogrammetric methods from aerial photographs taken 1948. Revised from aerial photographs taken 1957
Field annotated 1959. Map not field checked
Universal Transverse Mercator projection. 1927 North American datum
10,000-foot grid based on Alaska coordinate system, zone 2
1000 meter Universal Transverse Mercator grid ticks.
TRUE NORTH
MAGNETIC NORTH
28½°