



State of Alaska  
Department of Fish and Game  
Division of Sport Fish

Nomination Form  
Anadromous Waters Catalog

6B

Region III, Southwestern USGS Quad(s) Unimak D-1  
Anadromous Waters Catalog Number of Waterway 311-32-10600

Name of Waterway Divide Creek  USGS Name  Local Name  
 Addition  Deletion  Correction  Backup Information

ALASKA DEPT. OF FISH & GAME

For Office Use

Nomination # <u>09-118</u>	<u>[Signature]</u> Fisheries Scientist	<u>5/26/09</u> Date
Revision Year: <u>2010</u>	<u>[Signature]</u> Habitat Operations Manager	<u>5/20/09</u> Date
Revision to: Atlas _____ Catalog _____ Both <u>X</u>	<u>[Signature]</u> AWC Project Biologist	<u>02/09/09</u> Date
Revision Code: <u>B-1</u>	<u>[Signature]</u> Cartographer	<u>7/10/09</u> Date

OBSERVATION INFORMATION


Species	Date(s) Observed	Spawning	Rearing	Present	Anadromous
coho salmon	published in AMR, year in ( )			yes	<input checked="" type="checkbox"/>
					<input type="checkbox"/>
					<input type="checkbox"/>
					<input type="checkbox"/>
					<input type="checkbox"/>

**IMPORTANT:** Provide all supporting documentation that this water body is important for the spawning, rearing or migration of anadromous fish, including: number of fish and life stages observed; sampling methods, sampling duration and area sampled; copies of field notes; etc. **Attach a copy of a map showing location of mouth and observed upper extent of each species,** as well as other information such as: specific stream reaches observed as spawning or rearing habitat; locations, types, and heights of any barriers; etc.

**311-30.06. Divide Creek.** Aerial surveys have been conducted on this system since the **1960s** and observers have noted the presence of **sockeye, coho and chinook salmon**, which has been published in our ADF&G Annual Salmon Management Reports (AMR).  
**Please add coho (2000,2001,2002,2003,2004,2007) salmon; see attached map.**  
Add coho salmon present to 311-32-10600

Name of Observer (please print): on file; name and date is published in AMR  
Signature: \_\_\_\_\_ Date: \_\_\_\_\_  
Agency: Alaska Department of Fish & Game  
Address: 211 Mission Road  
Kodiak, Alaska 99615

This certifies that in my best professional judgment and belief the above information is evidence that this waterbody should be included in or deleted from the Anadromous Waters Catalog.  
Signature of Area Biologist: [Signature] Date: 11-26-08 Revision 02/08  
Name of Area Biologist (please print): Aaron Poetter, FBIII

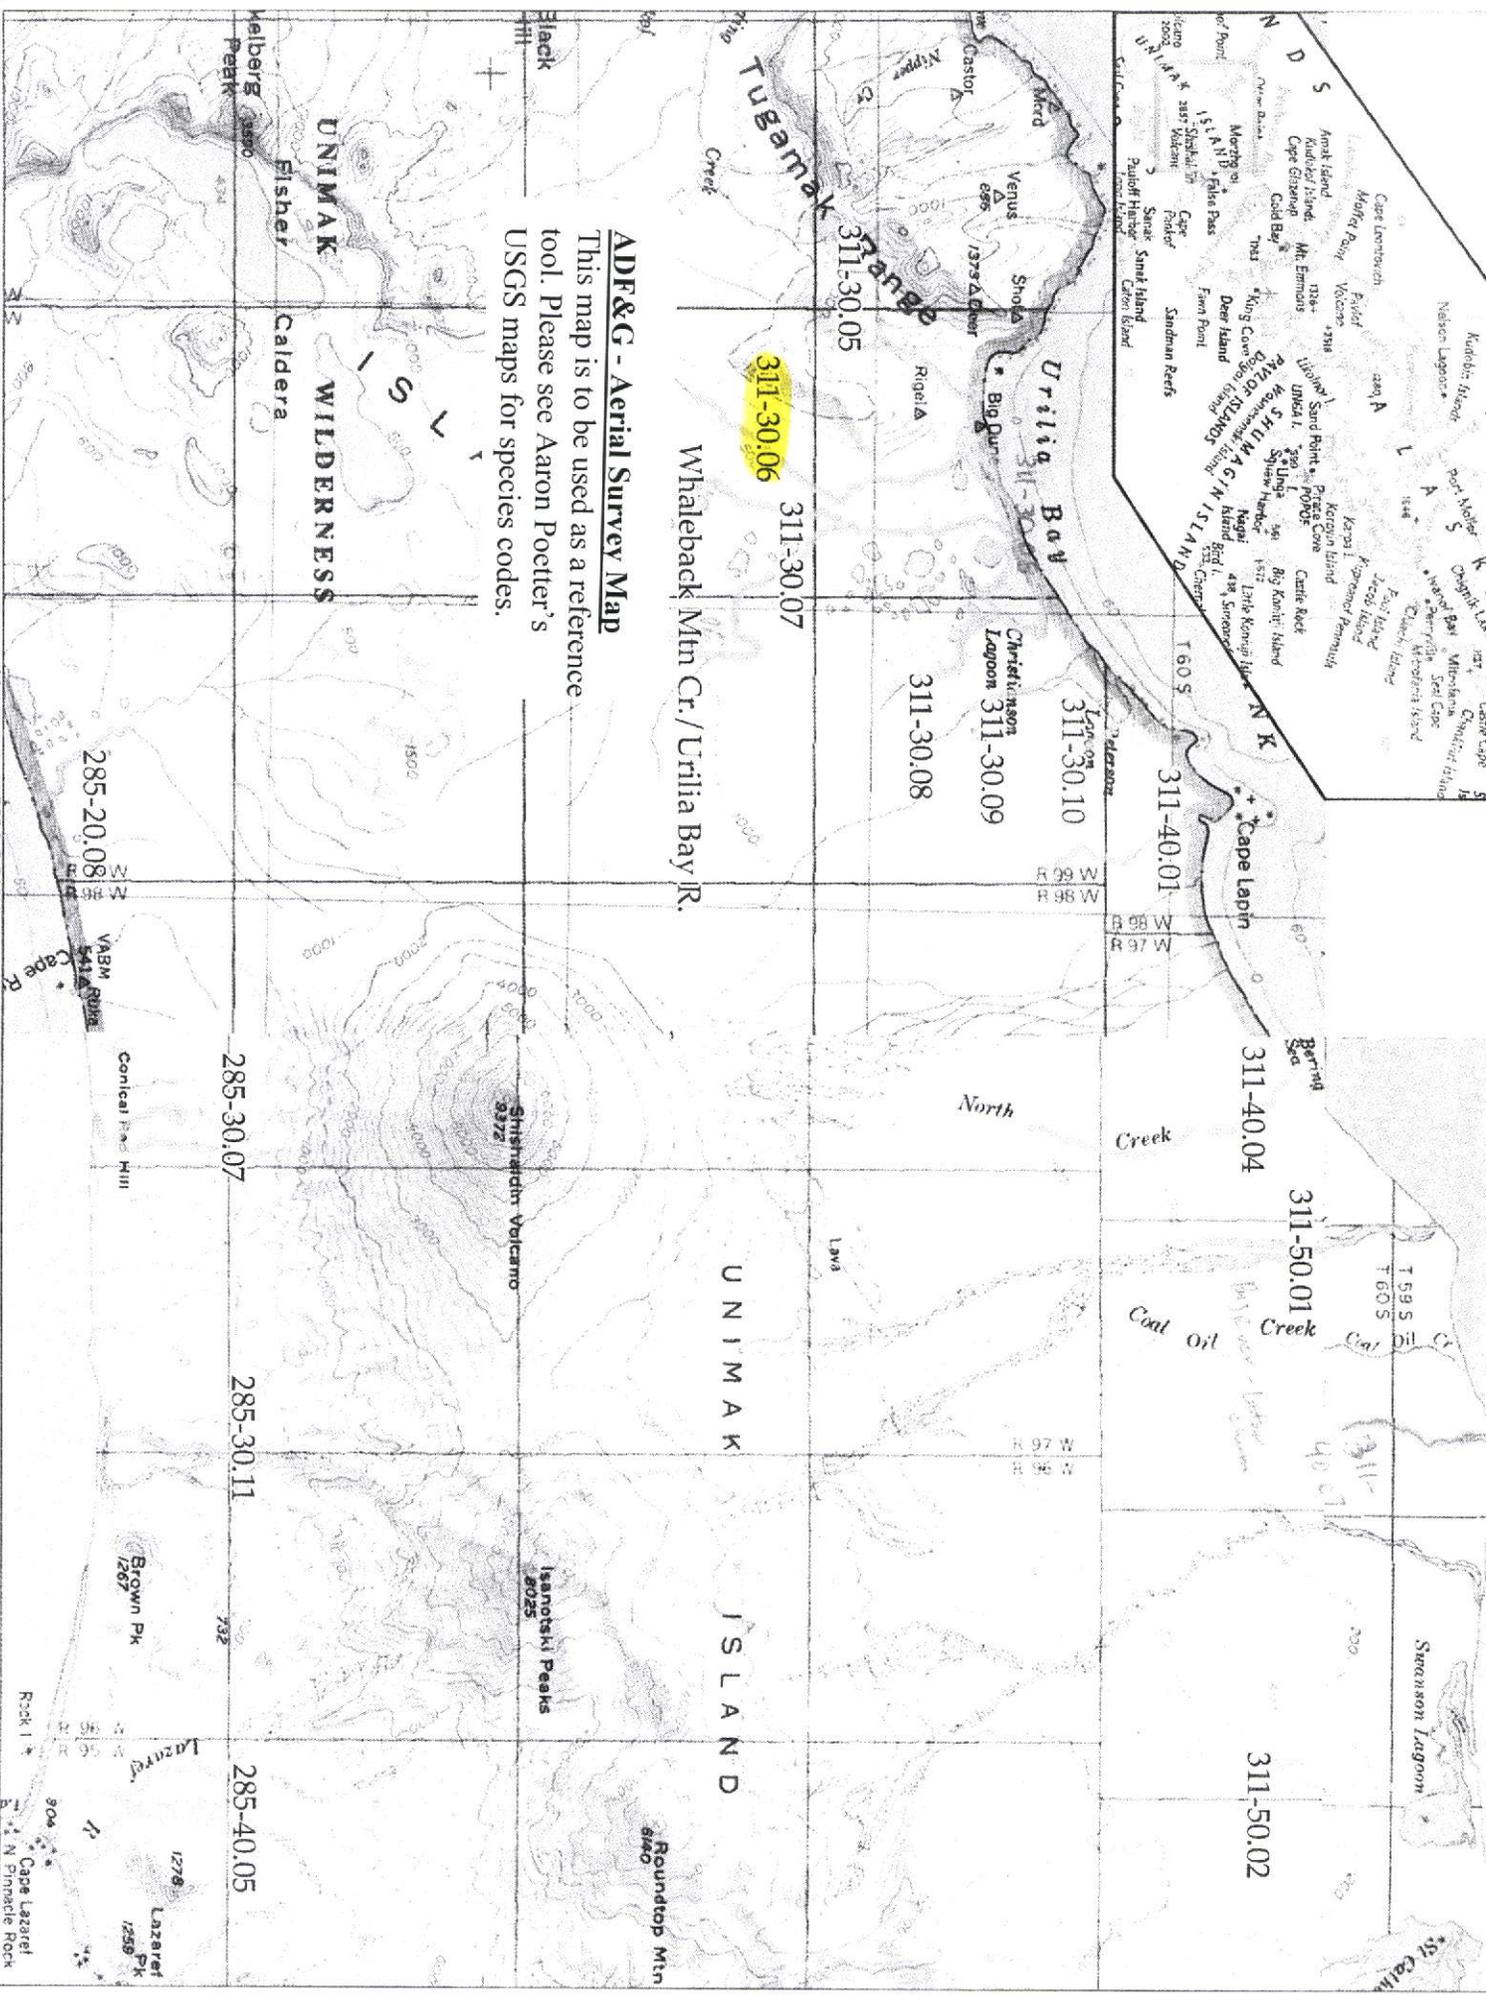

**ADFG - Aerial Survey Map**  
 This map is to be used as a reference tool. Please see Aaron Poetter's USGS maps for species codes.

Whaleback Mtn Cr./Utrilia Bay R.

311-30.06

311-30.07

311-30.05

311-30.08

311-30.09

311-30.10

311-40.01

311-40.04

311-50.01

311-50.02


285-30.07

285-30.11

285-40.05

285-20.08

Map created with TOPO® © 2003 National Geographic. [www.nationalgeographic.com/topo/](http://www.nationalgeographic.com/topo/)

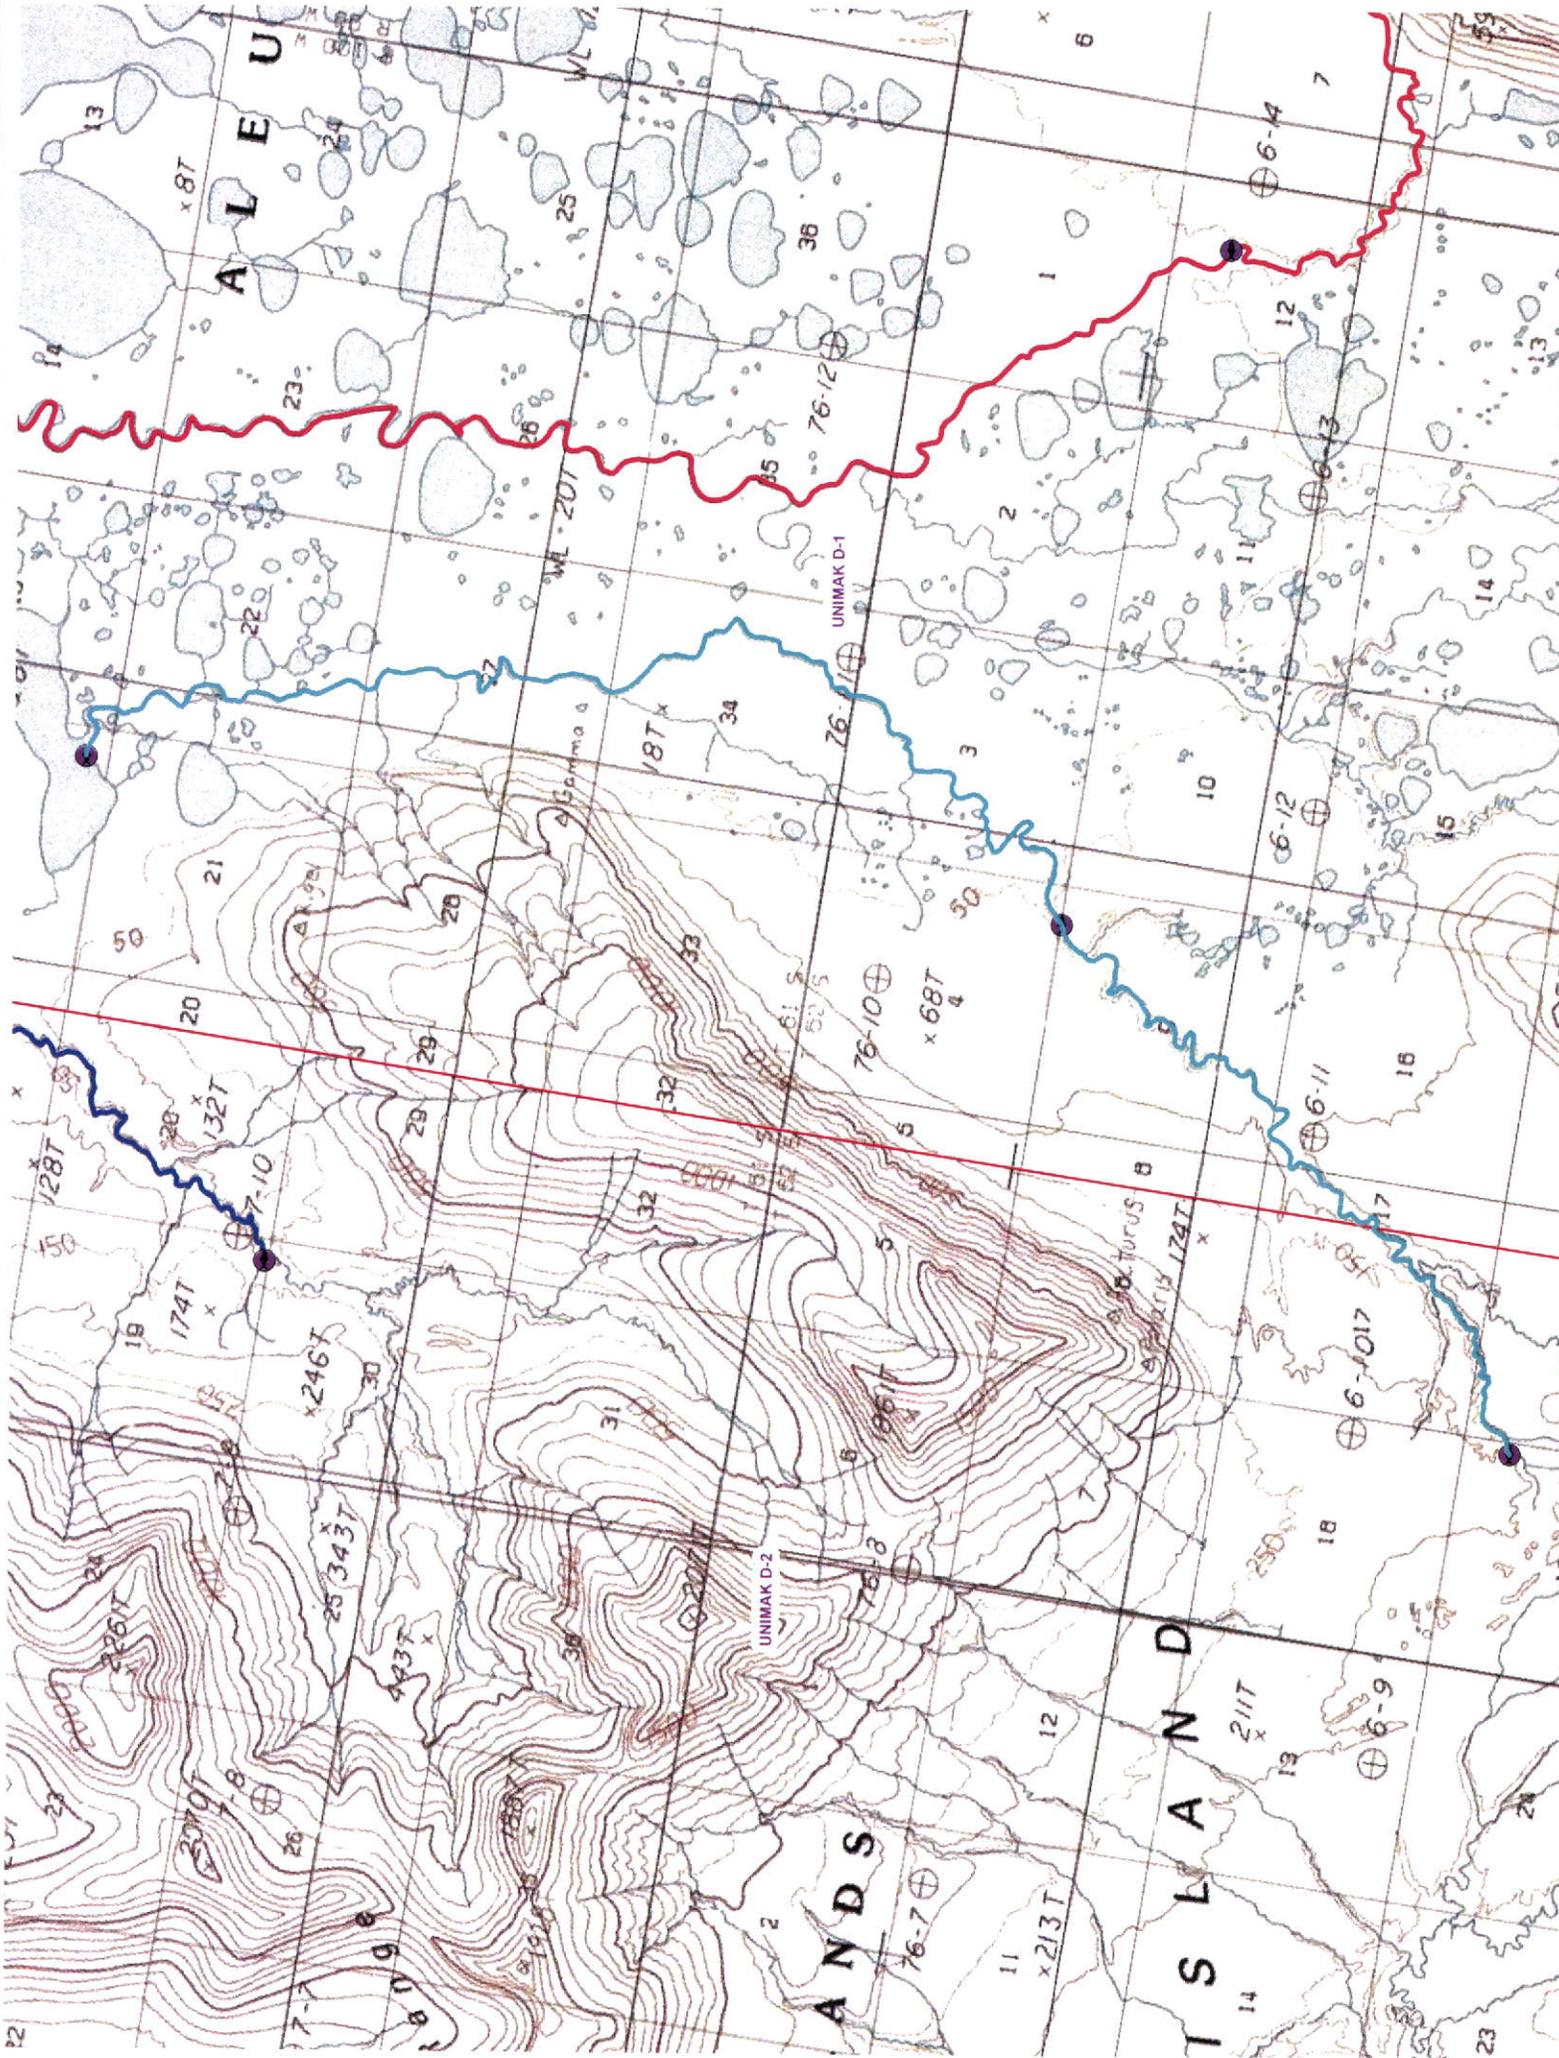

A L E U

ANDS

T S L A N D

UNIMAK D-1

UNIMAK D-2

x87

x132T

x246T

x343T

x493T

x7-10

x128T

x174T










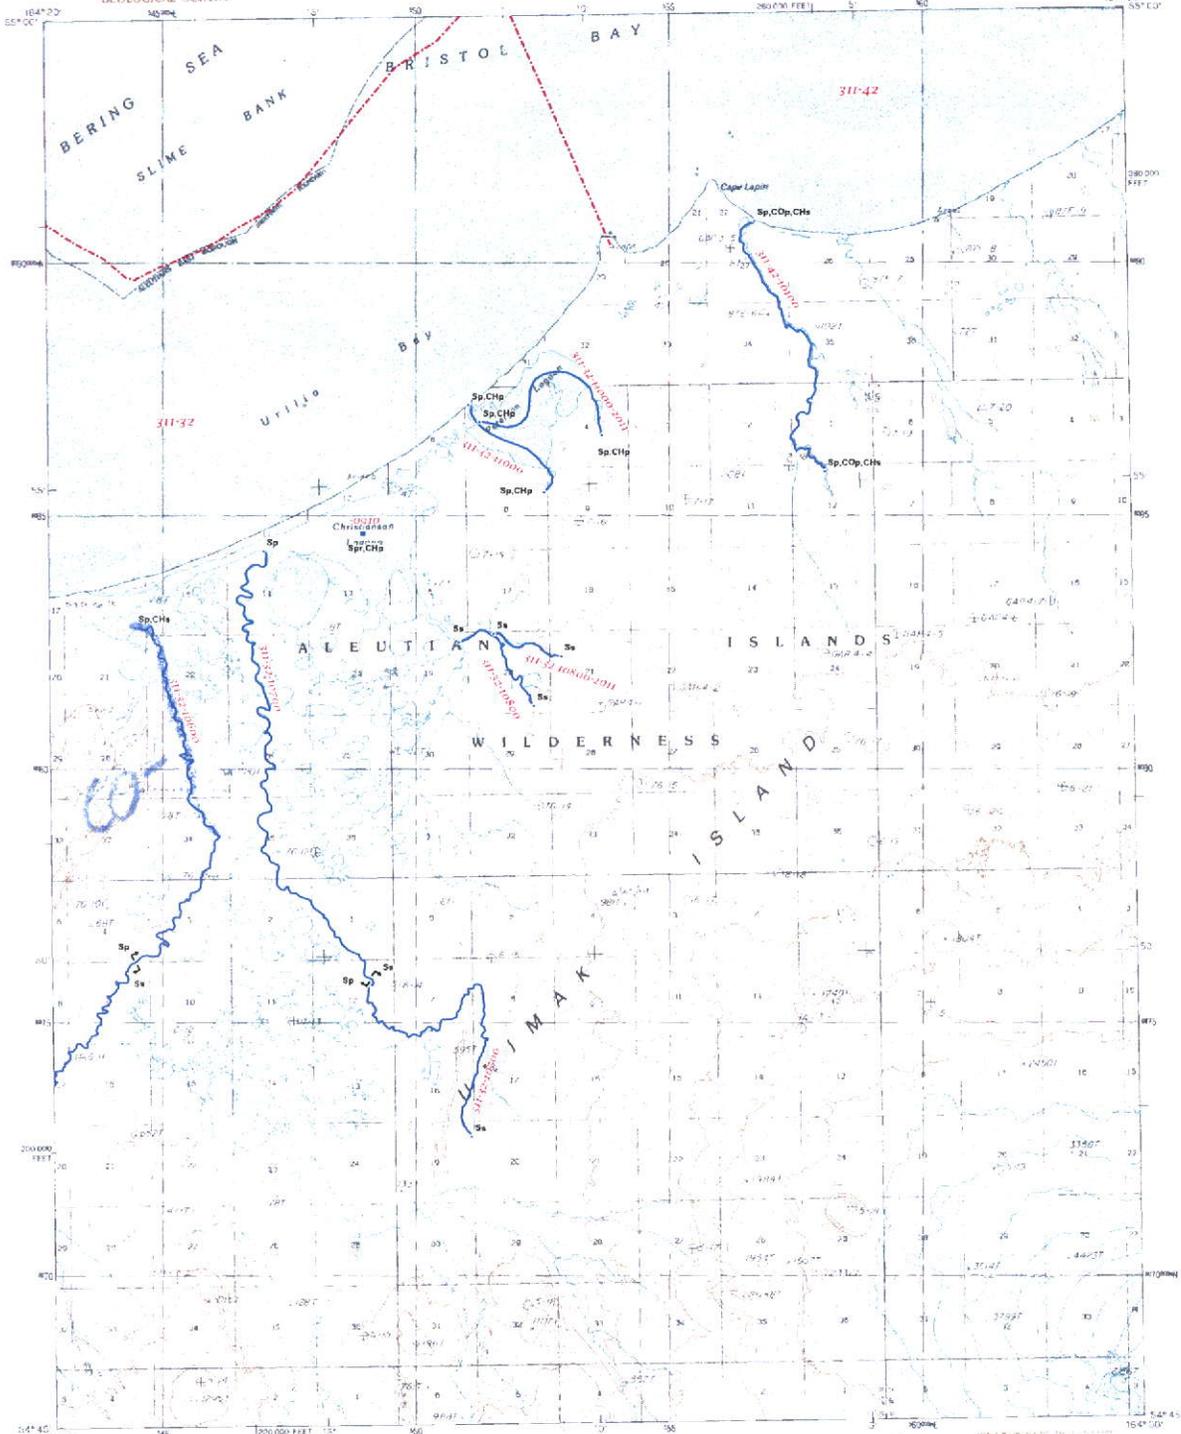


**Legend to Aaron Poetter's Maps**

- P = Purple**    **CO = Blue**
- CH = Green**    **S = Red**    **K = Yellow**
- DV = Orange**
- SH = Brown**

1:63,360 MAP  
Scale: 1:63,360  
1 inch = 1 mile

UNIMAK (D-1) QUADRANGLE ALASKA 1:63,360 SERIES (TOPOGRAPHIC)  
Produced by U.S. GEOLOGICAL SURVEY, FAIRBANKS, ALASKA 99701  
SOURCE: U.S. GEOLOGICAL SURVEY, U.S. DEPARTMENT OF THE INTERIOR

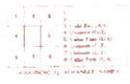

UNIMAK (D-1) ALASKA  
PROFESSIONAL FIGURE 1985  
54104-1-10-85

<ul style="list-style-type: none"> <li>△ Lower/Upper Point of Stream</li> <li>┆ Midstream Species Begin/End Point</li> <li>★ Short Stream (Under 690 feet)</li> <li>■ Lake</li> <li>▲ Barrier</li> <li>— Anadromous Streams</li> <li>▨ Anadromous Areas</li> <li>--- AWC Stat Area</li> <li>— Regional Boundary</li> </ul>	<p><b>SPECIES CODES</b></p> <ul style="list-style-type: none"> <li>CO chinook salmon</li> <li>CH chum salmon</li> <li>K chinook salmon (king)</li> <li>P pink salmon</li> <li>S sockeye salmon</li> <li>CT cutthroat trout</li> <li>DV dolly varden</li> <li>SF Inconnu (sheefish)</li> <li>SM smelt</li> <li>ST sturgeon</li> <li>SH steelhead</li> <li>W whitefish</li> <li>AC arctic char</li> </ul>	<p><b>LIFE STAGE CODES</b></p> <ul style="list-style-type: none"> <li>p Present</li> <li>m Migration</li> <li>r Rearing</li> <li>k Known</li> <li>s Spawning</li> </ul>	<p>Produced By State of Alaska Department of Fish and Game</p>	<p><b>Fish Distribution Database Atlas</b></p> <p>Quad No. 28</p> <p><b>Unimak</b></p> <p><b>D - 1</b></p> <p>Revision Date 04/19/2005</p>
--	---	---	--	--

Waters Important to Anadromous Fish are listed pursuant to AS 41.14.670. Specified species distribution and life functions reflect known data. Actual distribution and use may extend beyond specified limits. Migration upstream and/or downstream is assumed for specified stream reaches.



*NO data*

**Legend to Aaron Poetter's Maps**

- P = Purple**   **CO = Blue**
- CH = Green**   **S = Red**   **K = Yellow**
- DV = Orange**
- SH = Brown**

1:63 360 SERIES (TOPOGRAPHIC)  
SCALE 1:63 360

CONTOUR INTERVAL (30 FEET)  
UNIMAK (D-2) QUADRANGLE, ALASKA  
1:63 360 SERIES (TOPOGRAPHIC)

PRODUCED BY THE UNITED STATES GEOLOGICAL SURVEY  
CONTOUR INTERVAL (30 FEET)  
UNIMAK (D-2) QUADRANGLE, ALASKA  
1:63 360 SERIES (TOPOGRAPHIC)

1	2	3	4
5	6	7	8
9	10	11	12
13	14	15	16

UNIMAK (D-2), ALASKA  
PROVISIONAL EDITION 1989  
1:63 360 SERIES (TOPOGRAPHIC)

- Lower/Upper Point of Stream
- ⋈ Midstream Species Begin/End Point
- ★ Short Stream (Under 660 feet)
- Lake
- ▲ Barrier
- Anadromous Streams
- ▨ Anadromous Areas
- AWC Stat Area
- Regional Boundary

Waters Important to Anadromous Fish are listed pursuant to AS 41.14.870. Specified species distribution and life functions reflect known data. Actual distribution and use may extend beyond specified limits. Migration upstream and/or downstream is assumed for specified stream reaches.

SPECIES CODES		LIFE STAGE CODES	
CO	coho salmon	p	Present
CH	chum salmon	m	Migration
K	king salmon	r	Rearing
P	pink salmon	s	Spawning
S	sockeye salmon		
DV	dolly varden		
W	whitefish		
AC	arctic char		




Produced By  
State of Alaska  
Department of Fish and Game

**Fish Distribution Database Atlas**

**Unimak D - 2**

Revision Date 04/2003

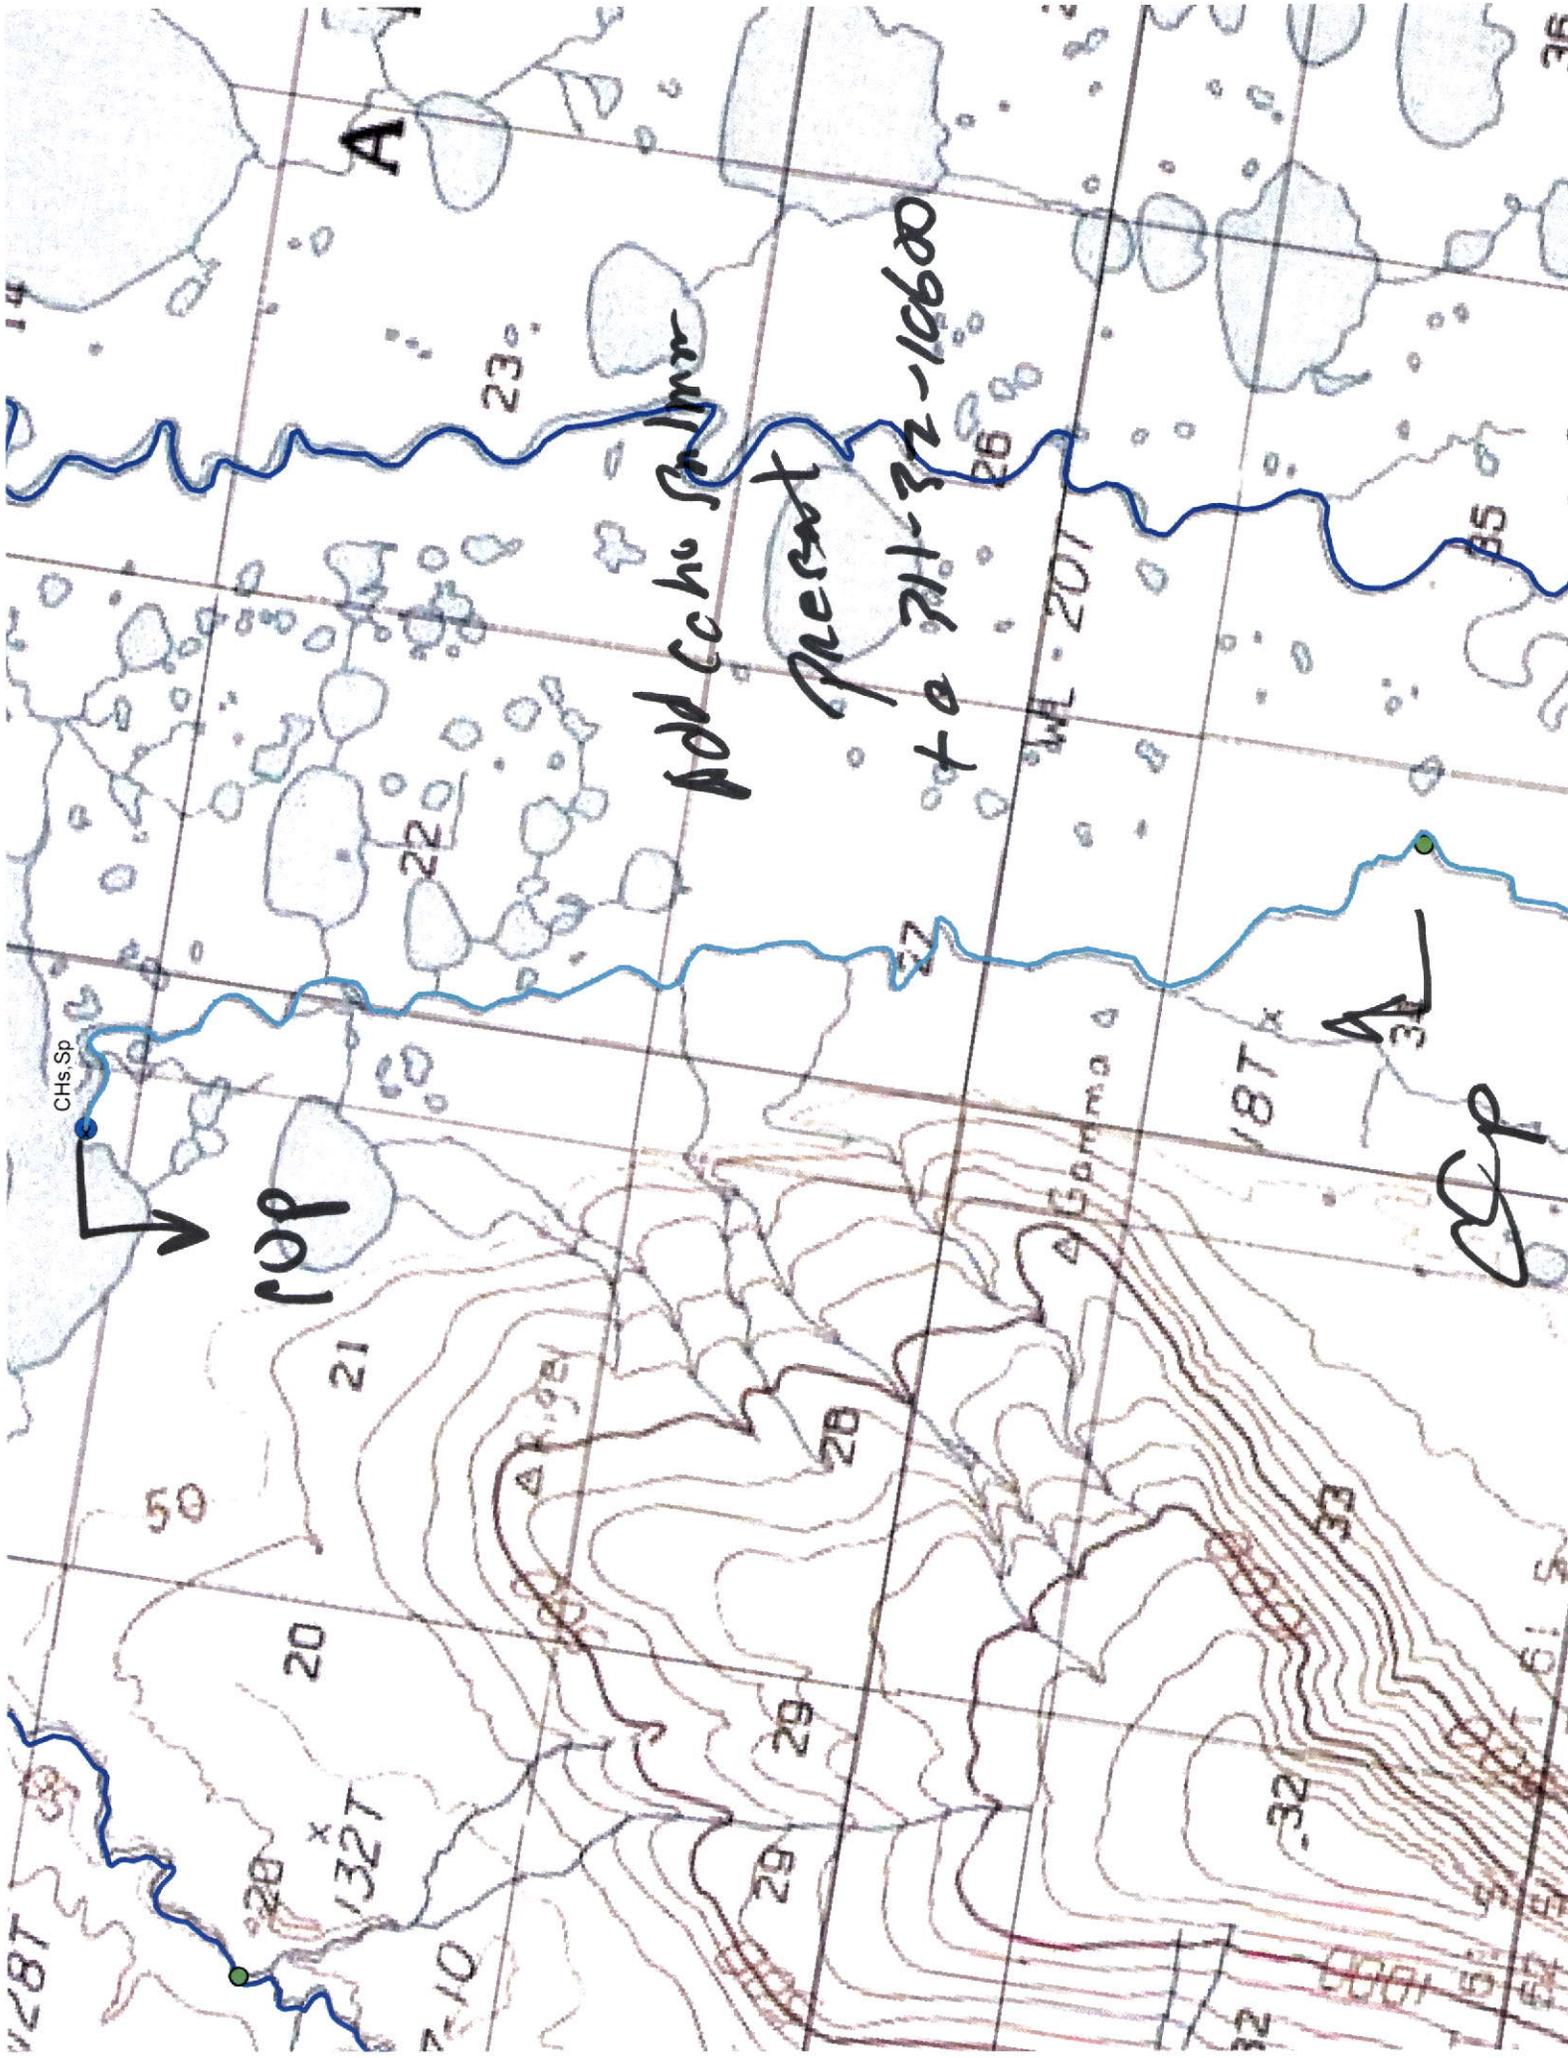

Add cch to Salmer  
Present  
to 711-32-10600

rop

ESP

CHs Sp



187

50

20

21

710

327

300

29

29

28

27

Gamma

WL-201

32

33

32

31

51

52

