State of Alaska
Department of Fish and Game
Nomination for Waters
Important to Anadromous Species 84-150

Tanaga I

(2)

[X] Addition [ ] Deletion

Name of Waterbody (if known): Lash Bay

Location:

Anadromous Waters Catalog Volume SW III

USGS 1:63,360 Quadrangle

or 1:250,000 (if 1:63,360 not available) Gareoli Islands

Species	Date(s) Observed	Stage(s) (Spawning, Rearing, Migration, and Overwintering)
Dolly Varden	9/6/82	

Comments: Please provide any clarifying information in addition to identification on Anadromous Waters Catalog Public Review Maps.

Refer to # 2 on map.
in lower part of stream open to ocean.

*This form must be accompanied by 1:63,360 or 1:250,000 quadrangle or copy of quadrangle identifying known extent of species.

Name of Observer (please print) Pat Hokes

Date: 11/8/83 Signature: PBHokes

State of Alaska
Department of Fish and Gam
Nomination for Waters
Important to Anadromous Species

Tamagu I.

(3)

[X] Addition [ ] Deletion

Name of Waterbody (if known): Figure Eight Crk

Location: 1 mi N.E. Whip Is. Outlet of Figure 8 Lake.

Anadromous Waters Catalog Volume SW III

USGS 1:63,360 Quadrangle

or 1:250,000 (if 1:63,360 not available) Gareoli Islands

Species	Date(s) Observed	Stage(s) (Spawning, Rearing, Migration, and Overwintering)
Dolly Varden	9/6/82	

Comments: Please provide any clarifying information in addition to identification on Anadromous Waters Catalog Public Review Maps.

refer to #3 on map.
in lower part of stream near ocean.

*This form must be accompanied by 1:63,360 or 1:250,000 quadrangle or copy of quadrangle identifying known extent of species.

Name of Observer (please print) Pat Holmes

Date: 11/8/83 Signature: PB Holmes

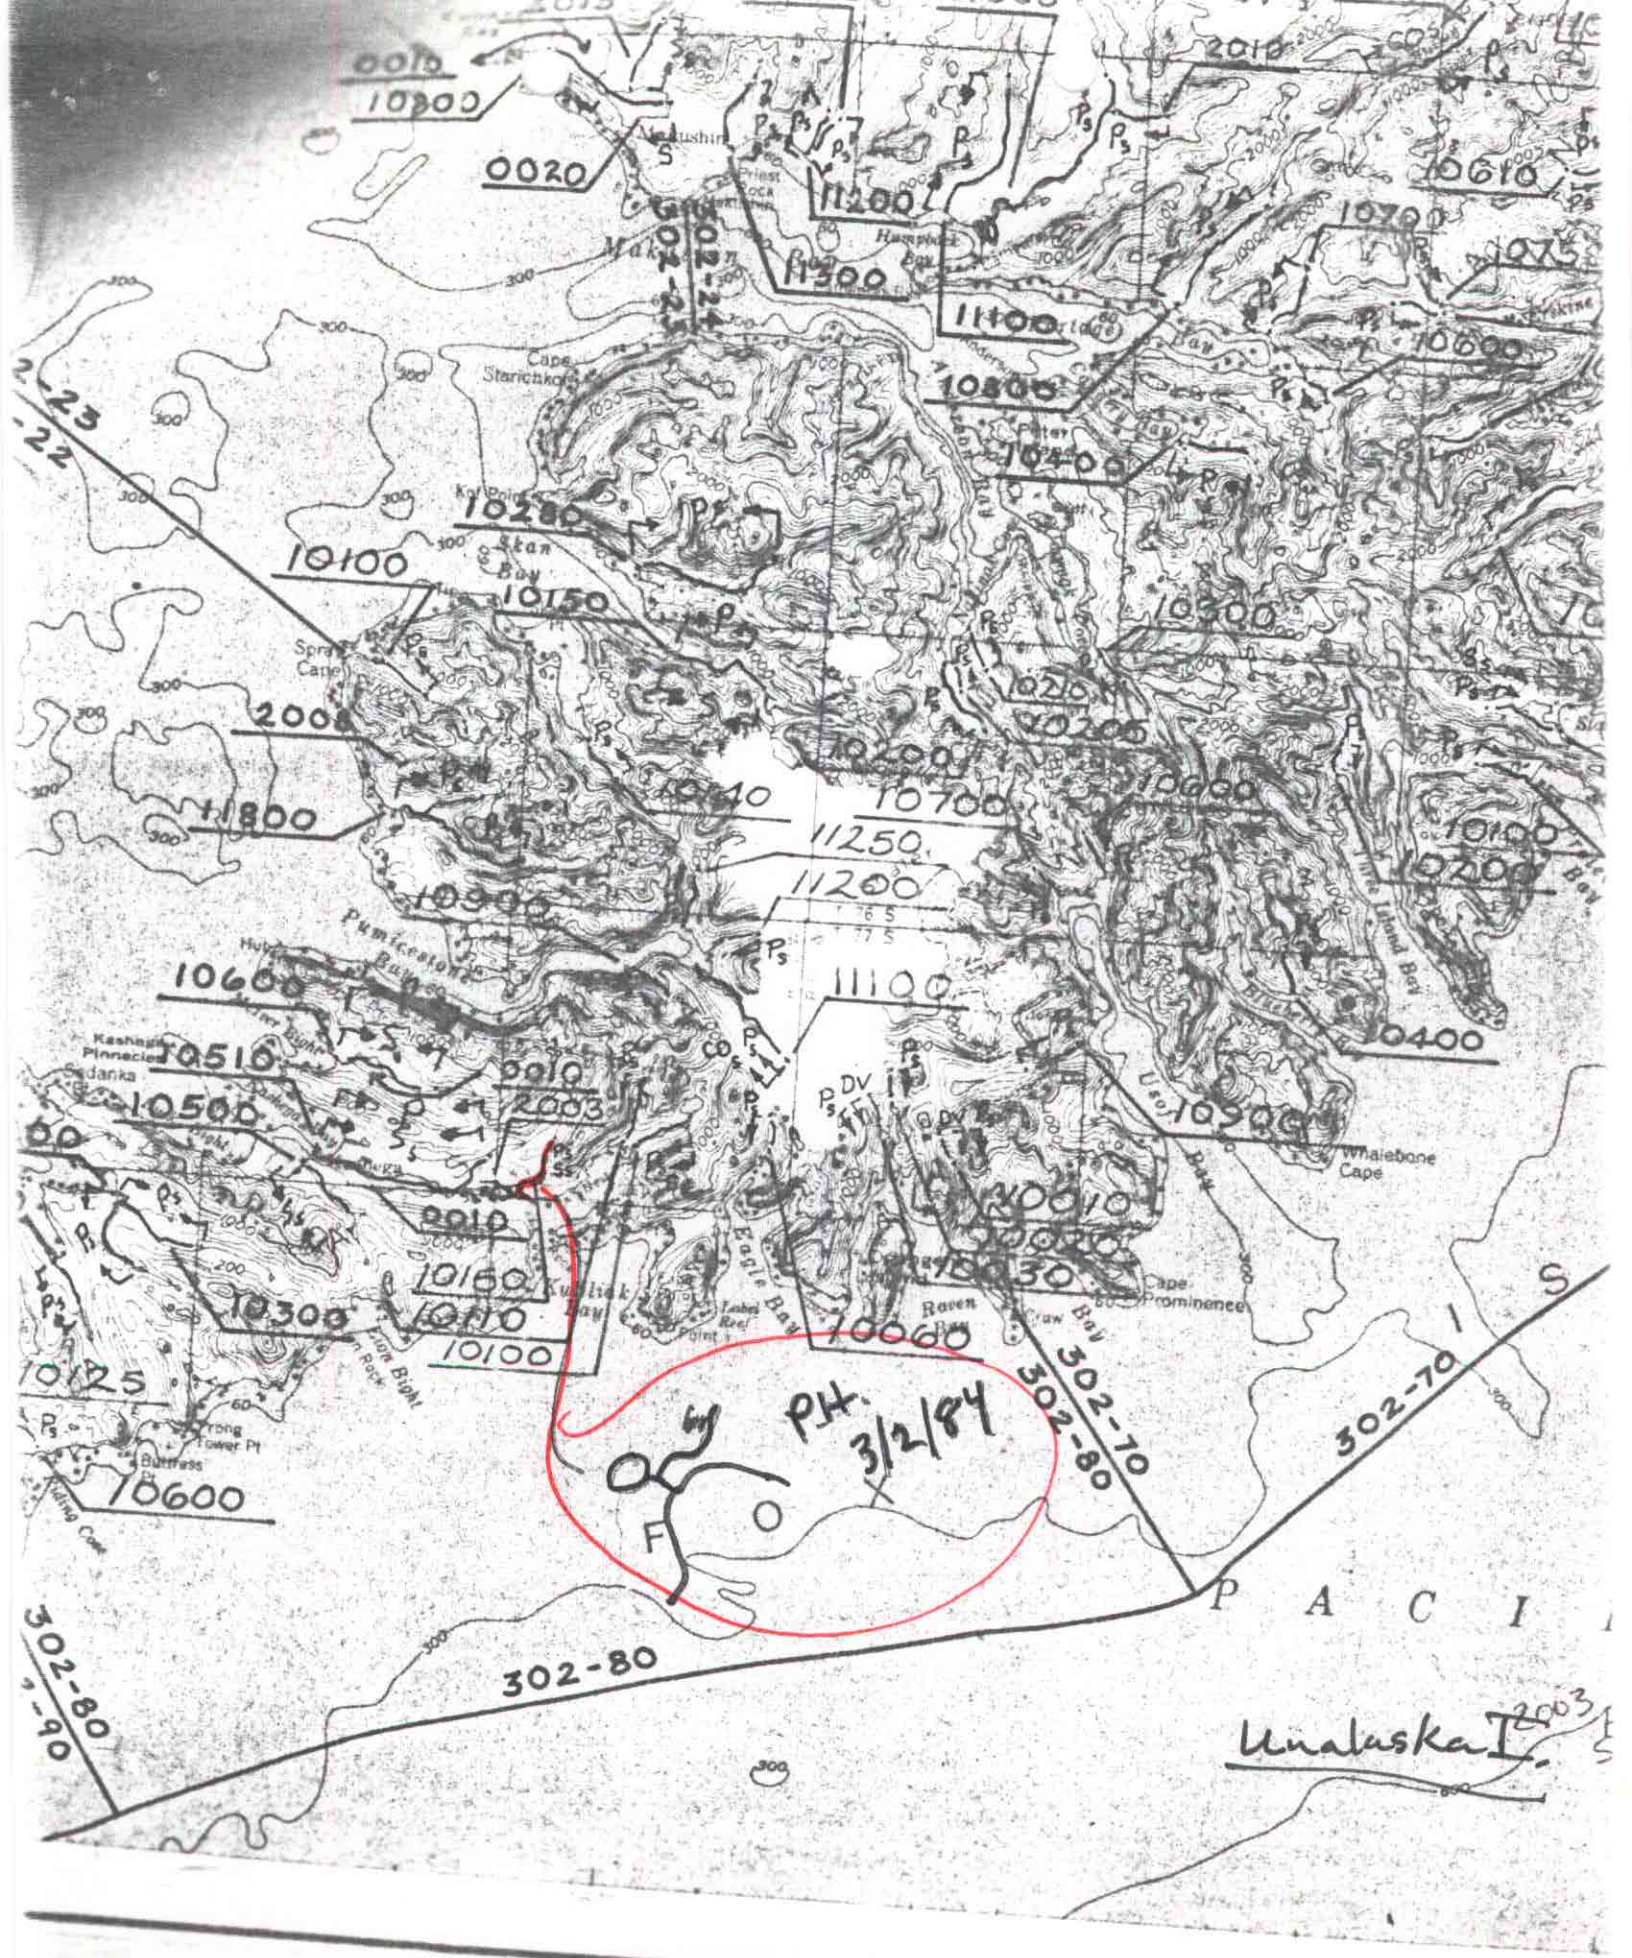

0010
10800
0020
11200
11300
11100
10800
10400
10610
10700
10600
10280
10100
10150
10300
2008
11800
10200
10700
11250
11200
10900
10600
11100
10510
10500
0010
2003
10400
10900
Whalebone Cape
0010
10160
10110
10100
10300
10125
10600
10060
10030
Cape Prominence
Raven Bay
Eagle Bay
Kubliak Bay
Pumicestone Bay
Kashega Pinnacles
Sedanka
Cape Starichkof
Skan Bay
Spray Cape
Priest Rock
Humpback Bay
Peter Bay
Tower Pt
Buttress
302-70
302-80
302-90
PH. 3/2/84
F O X
P A C I
Unalaska I.
2003

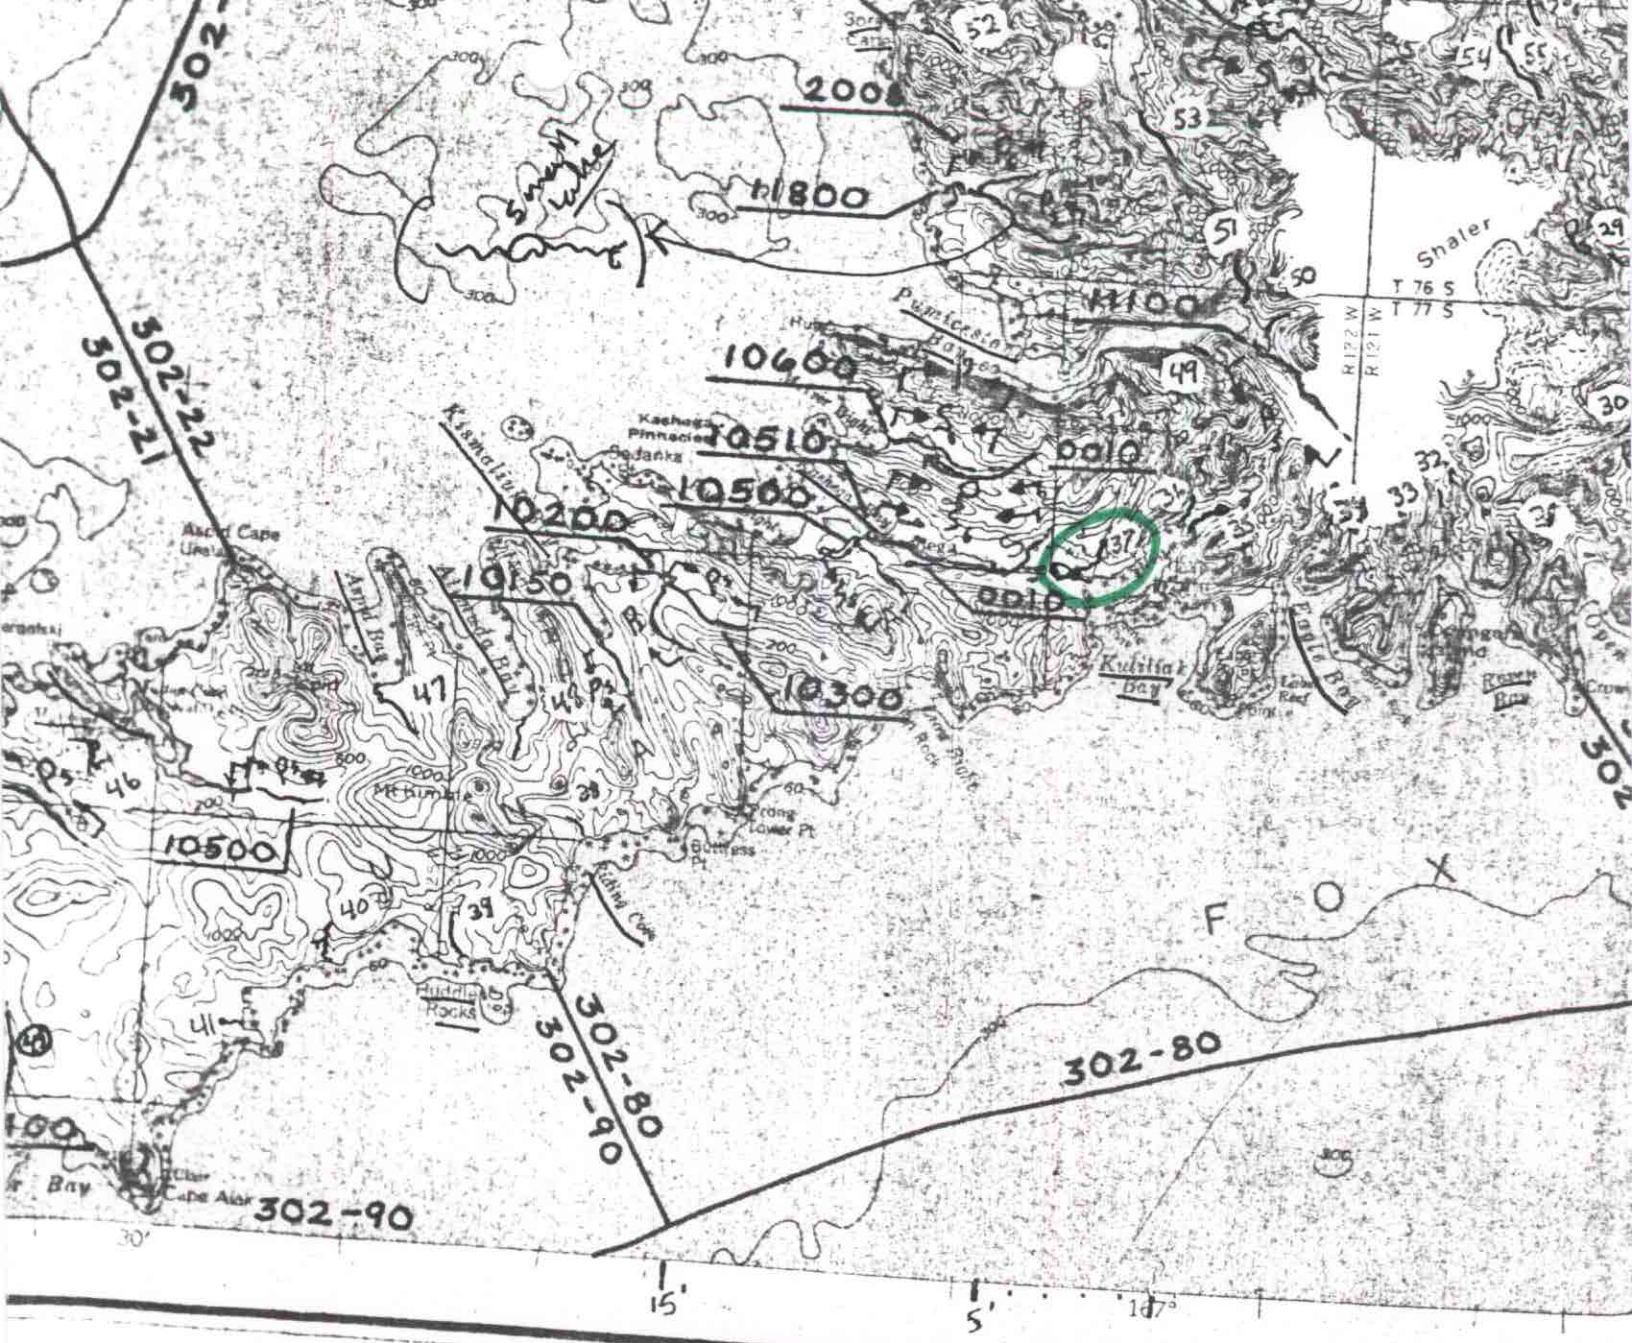

SCALE 1:250 000

5 0 5 10 15

5 0 5 10 15 20 KILOMETERS

CONTOUR INTERVAL 200 FEET

AREAS NOT SURVEYED IN DETAIL ARE INDICATED BY BROKEN LINES

NATIONAL GEODETIC VERTICAL DATUM OF 1929

DEPTH CURVES IN FEET—DATUM IS MEAN LOWER LOW WATER

SHORELINE SHOWN REPRESENTS THE APPROXIMATE LINE OF MEAN HIGH WATER

1951 MAGNETIC DECLINATION AT SOUTH EDGE OF SHEET VARIES FROM 14°30' TO 16°00' EAST

THIS MAP IS AVAILABLE IN BOTH SHADED RELIEF AND CONTOUR EDITIONS

FOR SALE BY U. S. GEOLOGICAL SURVEY

FAIRBANKS, ALASKA 99701, DENVER, COLORADO 80225, OR RESTON, VIRGINIA 22092

A FOLDER DESCRIBING TOPOGRAPHIC MAPS AND SYMBOLS IS AVAILABLE ON REQUEST