10/16/84 84-189

ALASKA DEPT. OF
FISH & GAME

OCT 01 1984

REGION IV
HABITAT DIVISION

STATE OF ALASKA
DEPARTMENT OF FISH AND GAME
NOMINATION FOR WATERS
IMPORTANT TO ANADROMOUS SPECIES

ALASKA DEPARTMENT OF FISH AND GAME
COMMERCIAL FISH
SEP 28 1984
SHELLFISH
KODIAK

[X] ADDITION [ ] DELETION

NAME OF WATERBODY (IF KNOWN) WESTFORK CREEK 258-403

LOCATION:

ANADROMOUS WATERS CATALOG VOLUME SW REGION; RESOURCE MGMT. REGION III

USGS 1:63,360 QUADRANGLE KODIAK A-4 (1952)

OR 1:250,000 (IF 1:63,360 NOT AVAILABLE)

SPECIES	DATE(S) OBSERVED	STAGE(S) (SPAWNING, REARING, MIGRATION, AND OVERWINTERING)
PINKS	8/28/84	MIGRATION, SPAWNING
CHUMS	9/82	SPAWNING, MIGRATION

COMMENTS: PLEASE PROVIDE ANY CLARIFYING INFORMATION IN ADDITION TO IDENTIFICATION ON ANADROMOUS WATERS CATALOG PUBLIC REVIEW MAPS.

AERIAL SURVEY OBSERVATIONS BOTH YEARS. 1982 OBSERVATION WERE BY D. PROKOPOWICH.

add Stream 258-40-~~1008~~ 10010

*THIS FORM MUST BE ACCOMPANIED BY 1:63,360 OR 1:250,000 QUADRANGLE OR COPY OF QUADRANGLE IDENTIFYING KNOWN EXTENT OF SPECIES.

NAME OF OBSERVER (PLEASE PRINT) LARRY MALLOY FOR KEN MANTHEY/DAVE PROKOPOWICH

DATE: 9/26/84 SIGNATURE: Larry Malloy
Ken Manthey

10/84

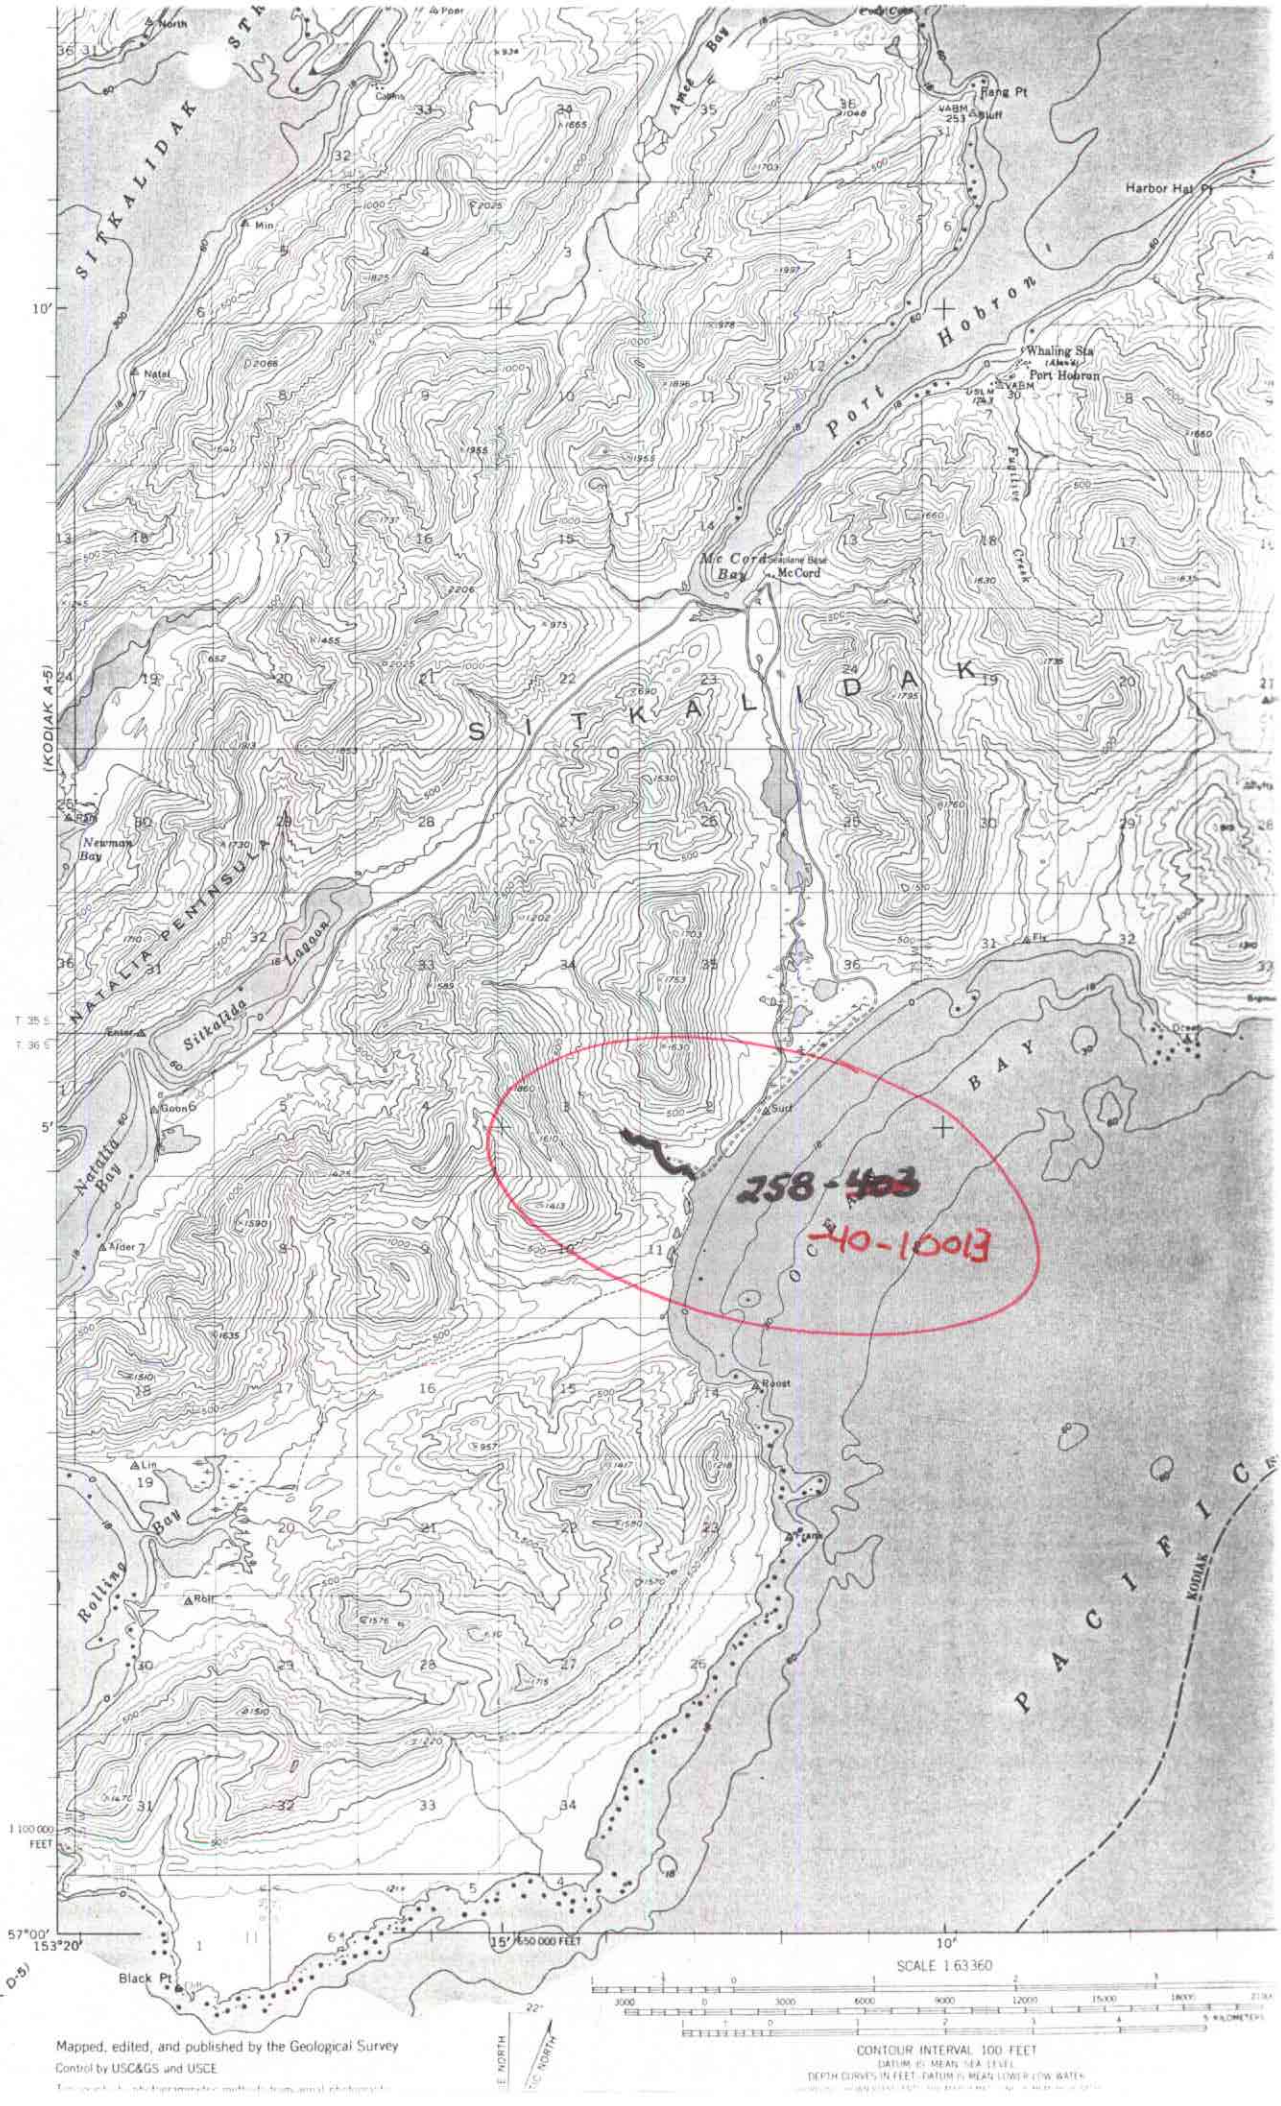
SITKALIDAK
Port Hobron
Whaling Sta
Port Hobron
Harbor Hat Pt
Fang Pt
Amee Bay
Mc Cord Bay
McCord
Newman Bay
NATALIA PENINSULA
Sitkalida Lagoon
Natalia Bay
Rolling Bay
Black Pt
PACIFIC
KODIAK
(KODIAK A-5)
(KAGUYAK D-5)
T. 35 S.
T. 36 S.
10'
5'
57°00'
153°20'
15'
10'
1 100 000 FEET
650 000 FEET
258-403
-40-10013
SCALE 1:63 360
CONTOUR INTERVAL 100 FEET
DATUM IS MEAN SEA LEVEL
DEPTH CURVES IN FEET, DATUM IS MEAN LOWER LOW WATER
Mapped, edited, and published by the Geological Survey
Control by USC&GS and USCE