84-190

STATE OF ALASKA
DEPARTMENT OF FISH AND GAME
NOMINATION FOR WATERS
IMPORTANT TO ANADROMOUS SPECIES

ALASKA DEPT. OF
FISH & GAME

OCT 01 1984

REGION IV
HABITAT DIVISION

ALASKA DEPARTMENT OF FISH AND GAME
COMMERCIAL FISH
SEP 28 1984
KODIAK

[X] ADDITION [ ] DELETION

Reply 10/16/84

NAME OF WATERBODY (IF KNOWN) BARN CREEK 258-404

LOCATION:

ANADROMOUS WATERS CATALOG VOLUME SW REGION; RESOURCE MGMT. REGION III

USGS 1:63,360 QUADRANGLE KODIAK A-4 (1952)

OR 1:250,000 (IF 1:63,360 NOT AVAILABLE)

SPECIES	DATE(S) OBSERVED	STAGE(S) (SPAWNING, REARING, MIGRATION, AND OVERWINTERING)
Pinks	8/28/84	MIGRATION, SPAWNING

COMMENTS: PLEASE PROVIDE ANY CLARIFYING INFORMATION IN ADDITION TO IDENTIFICATION ON ANADROMOUS WATERS CATALOG PUBLIC REVIEW MAPS.

AERIAL SURVEY OBSERVATION.

Add # 258-40-~~1004~~ 10006

*THIS FORM MUST BE ACCOMPANIED BY 1:63,360 OR 1:250,000 QUADRANGLE OR COPY OF QUADRANGLE IDENTIFYING KNOWN EXTENT OF SPECIES.

NAME OF OBSERVER (PLEASE PRINT) LARRY MALLOY FOR KEN MANTHEY

DATE: 9/26/84 SIGNATURE: Larry Malloy
Ken K. Manthey

SJS
10/26/84
10/84 CP

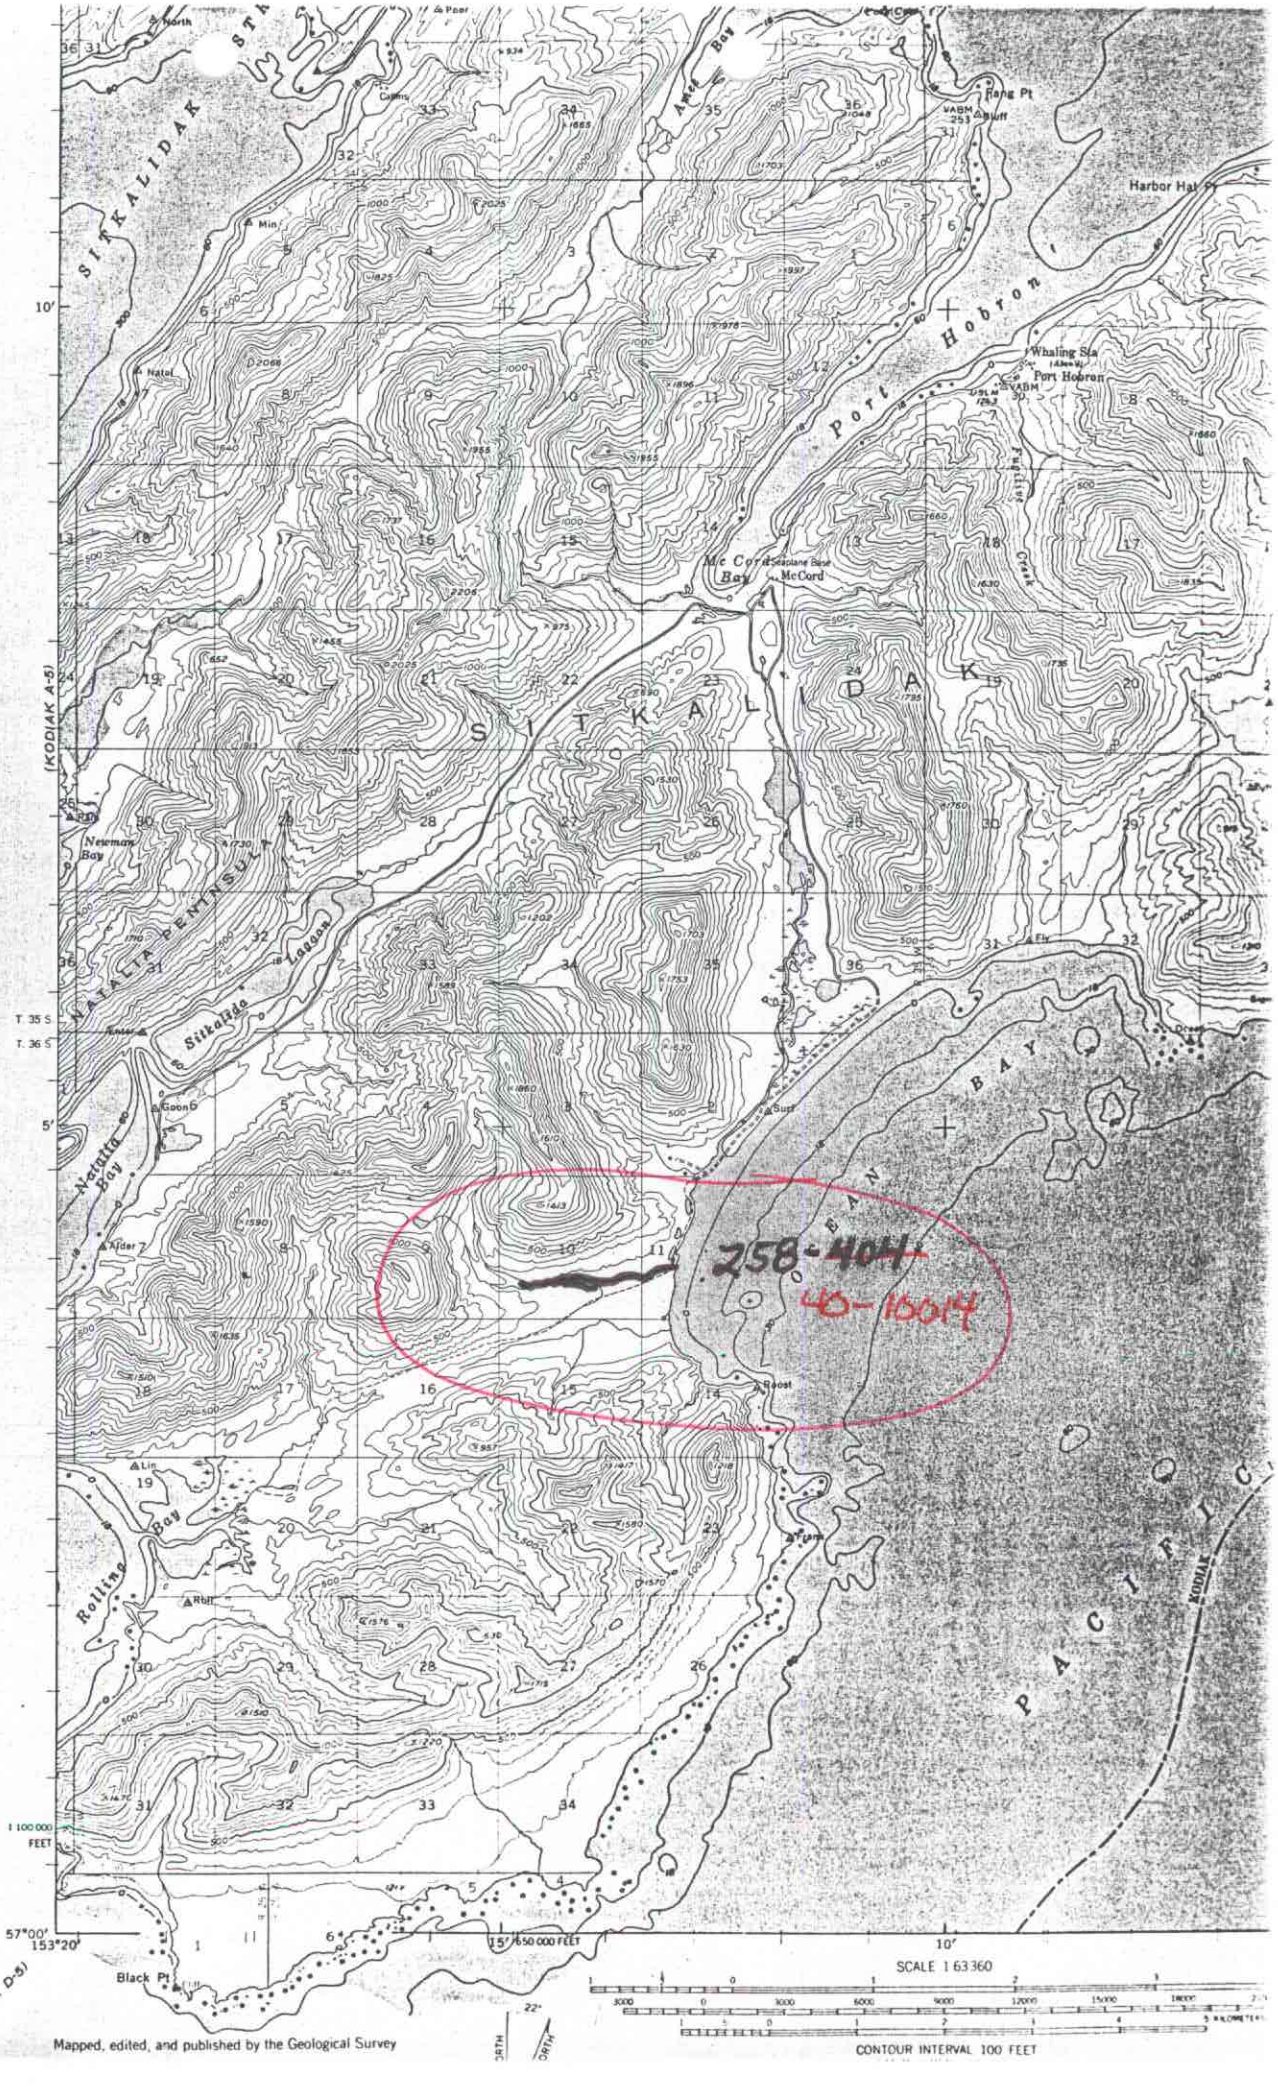
SITKALIDAK
Port Hobron
Whaling Sta
Port Hobron
Harbor Hat Pt
Fang Pt
Bluff
Amee Bay
Mc Cord Bay
Seaplane Base
McCord
SITKALIDAK
NATALIA PENINSULA
Sitkalida Lagoon
Newman Bay
Natalia Bay
Rolling Bay
Black Pt
PACIFIC
KODIAK
(KODIAK A-5)
(KAGUYAK D-5)
T. 35 S.
T. 36 S.
10'
5'
57°00'
153°20'
15'
10'
1 100 000 FEET
650 000 FEET
258-404
40-10014
SCALE 1:63 360
CONTOUR INTERVAL 100 FEET
Mapped, edited, and published by the Geological Survey