State of Alaska
Department of Fish and Game
Public Review Nomination for Waters
Important to Anadromous Species

1984 REVISION

84-262

X Addition
and correction

___ Deletion

Name of Waterbody (if known): Pumice Creek
321-10-10030-2014

Location:

Anadromous Waters Catalog Volume and Number SW #3

USGS 1:63,360 Quadrangle Ugashik B-6

or 1:250,000 (if 1:63,360 not available) ___

Species	Date(s) Observed	Stage(s) (Spawning, Rearing, Migration)
King salmon	Aug 2, 1983, Aug 15, 1983	migration
Chum salmon	"	"

Comments: Please provide any clarifying information. Also, please include a map of the area identifying the stream reach. This can be a copy of the map from the Anadromous Waters Atlas.

R. Russel nomunated K & CH salmon for Pumice Creek (refer to attached nomination forms). The lower limit of both K and CH must be drafted to the juncture with King Salmon River on Ugashik B-6 (map attached) life function is migration only.

Drafted Rew 1/84

Name of Observer (please print) Phyllis Weber

Date: Jan 17, 1984 Signature: Phyllis Weber

Address: RII, Habitat

Thisley OCC
Cmy 1/23/84

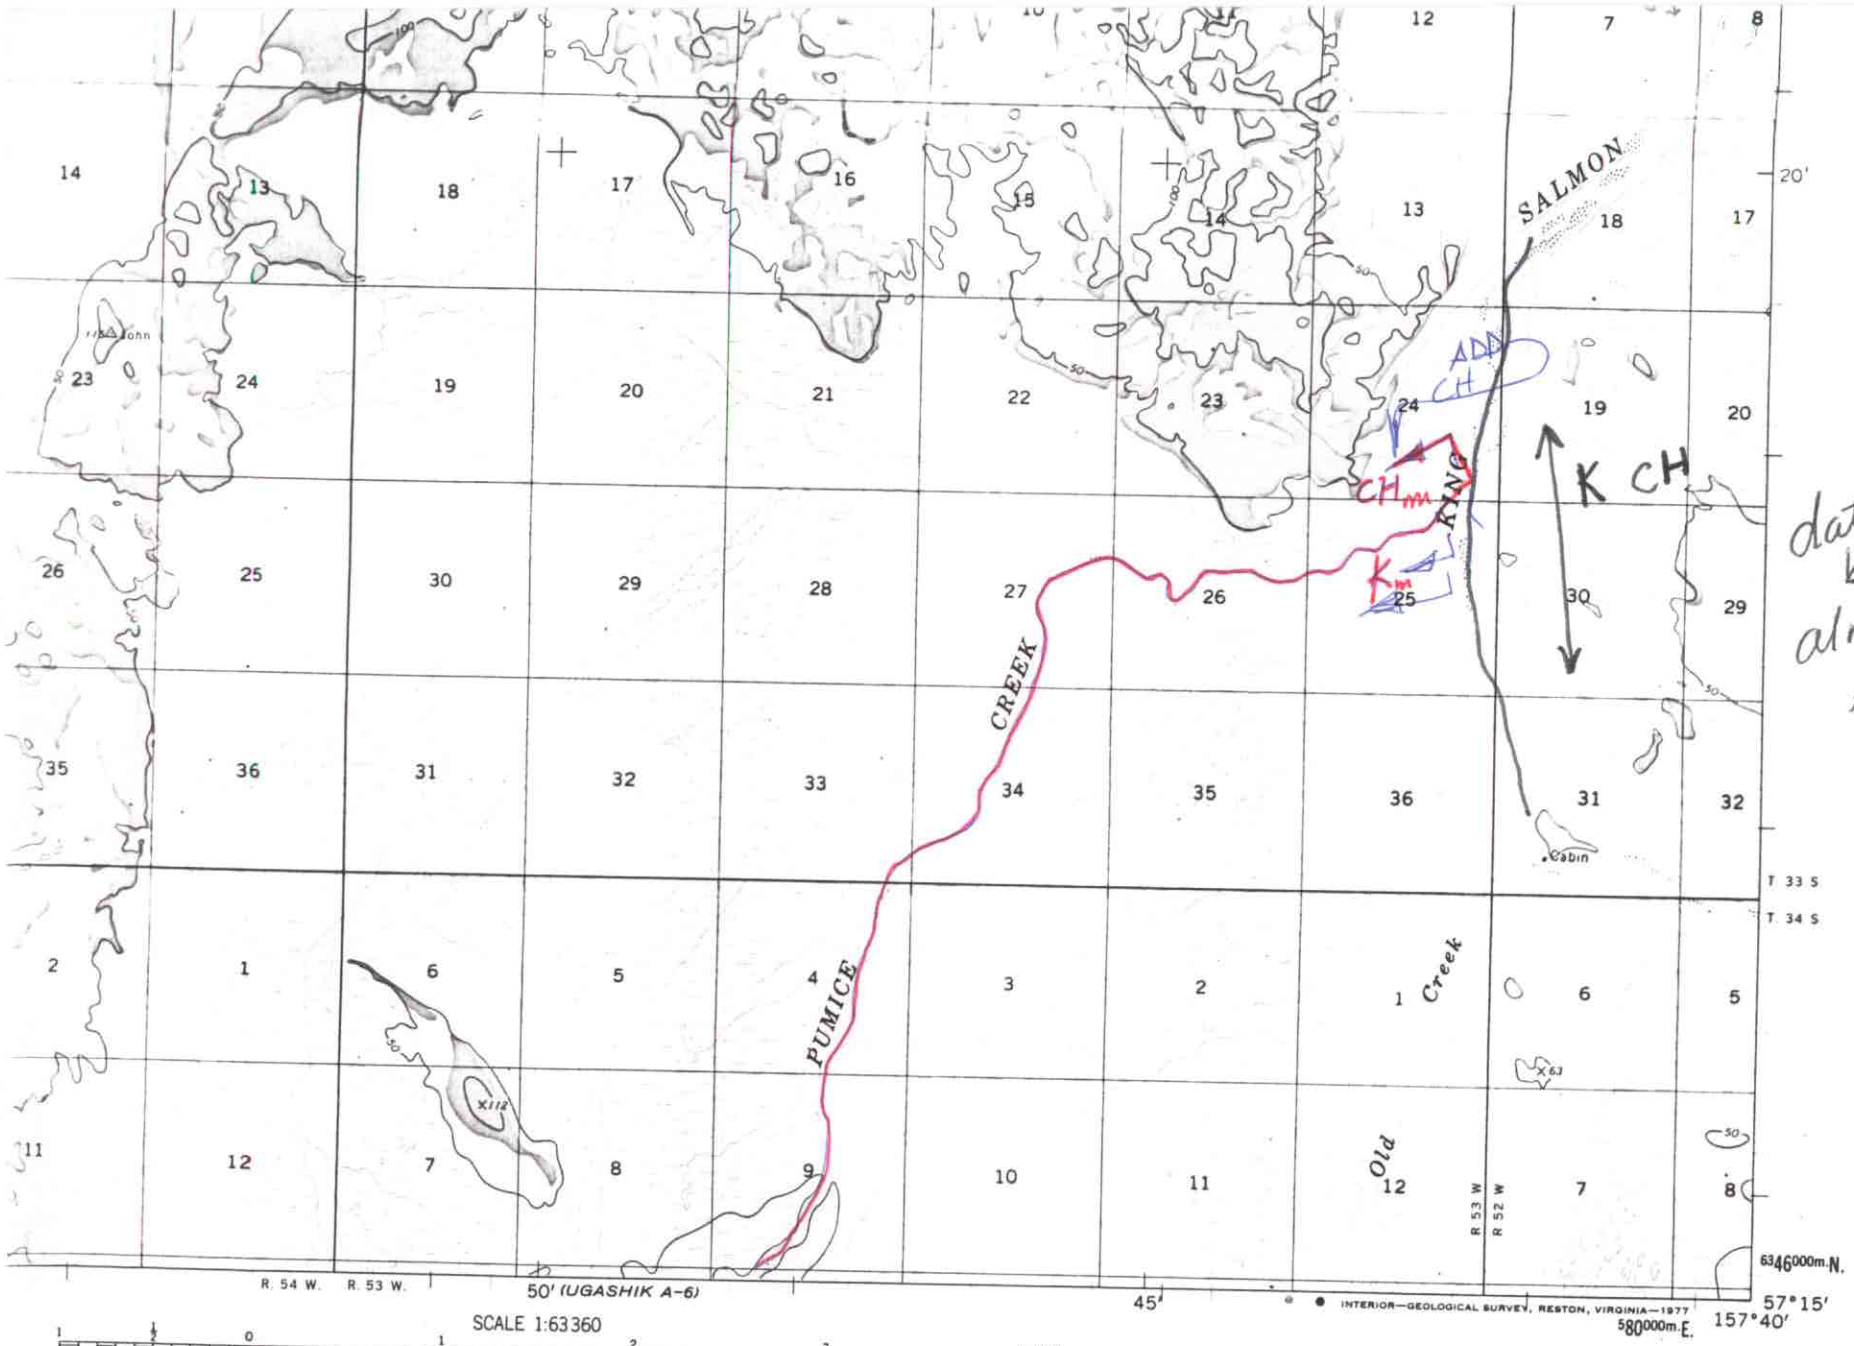

SCALE 1:63360

1 ½ 0 1 2 3 4 MILES

3000 0 3000 6000 9000 12000 15000 18000 21000 FEET

1 .5 0 1 2 3 4 5 KILOMETERS

20½°

MAGNETIC NORTH

ATE MEAN
ION, 1963

CONTOUR INTERVAL 50 FEET
NATIONAL GEODETIC VERTICAL DATUM OF 1929
SHORELINE SHOWN REPRESENTS THE APPROXIMATE LINE OF MEAN HIGH WATER
THE MEAN RANGE OF TIDE IS APPROXIMATELY 11 FEET

ROAD CLASSIFICATION
Unimproved dirt

QUADRANGLE LOCATION

FOR SALE BY U. S. GEOLOGICAL SURVEY
FAIRBANKS, ALASKA 99701, DENVER, COLORADO 80225, OR RESTON, VIRGINIA 22092
A FOLDER DESCRIBING TOPOGRAPHIC MAPS AND SYMBOLS IS AVAILABLE ON REQUEST

UGASHIK (B-6), ALASKA
N5715—W15740/15X20

1963