Drafted 7.2. 11/6/85

86-214
1986

State of Alaska
Department of Fish and Game
Public Review Nomination for Waters
Important to Anadromous Species

OK SRS 11/13/85
X

[X] Addition [ ] Deletion

Name of Waterbody (if known): _____

Location: (Terminus) 54° 26' 14" N. lat. 162° 49' 12" W. long Stream whose terminus is on West end of Sanak Island.

Anadromous Waters Catalog Volume and Number 283-10-10070 + lakes

USGS 1:63,360 Quadrangle _____

or 1:250,000 (if 1:63,360 not available) FALSE PASS

Species	Date(s) Observed	Stage(s) (Spawning, Rearing, Migration)
Sockeye Salmon	9-8-85	600 Some Spawning, some still schooled.
Pink Salmon	9-8-85	7,000 Spawning. An additional 3000 carcasses

Comments: Please provide any clarifying information in addition to identification on Anadromous Waters Catalog Public Review Maps.

Sockeye in lakes (5), pinks below lakes.

ADF&G Survey - Gruman Goose

Name of Observer (please print) Arnold R. Shaul

Date: 9-11-85 Signature: Arnold R. Shaul

OK Rance Lilley 11/4/85

ALASKA DEPT. OF
FISH & GAME

SEP 12 1985

HABITAT
REGIONAL OFFICE

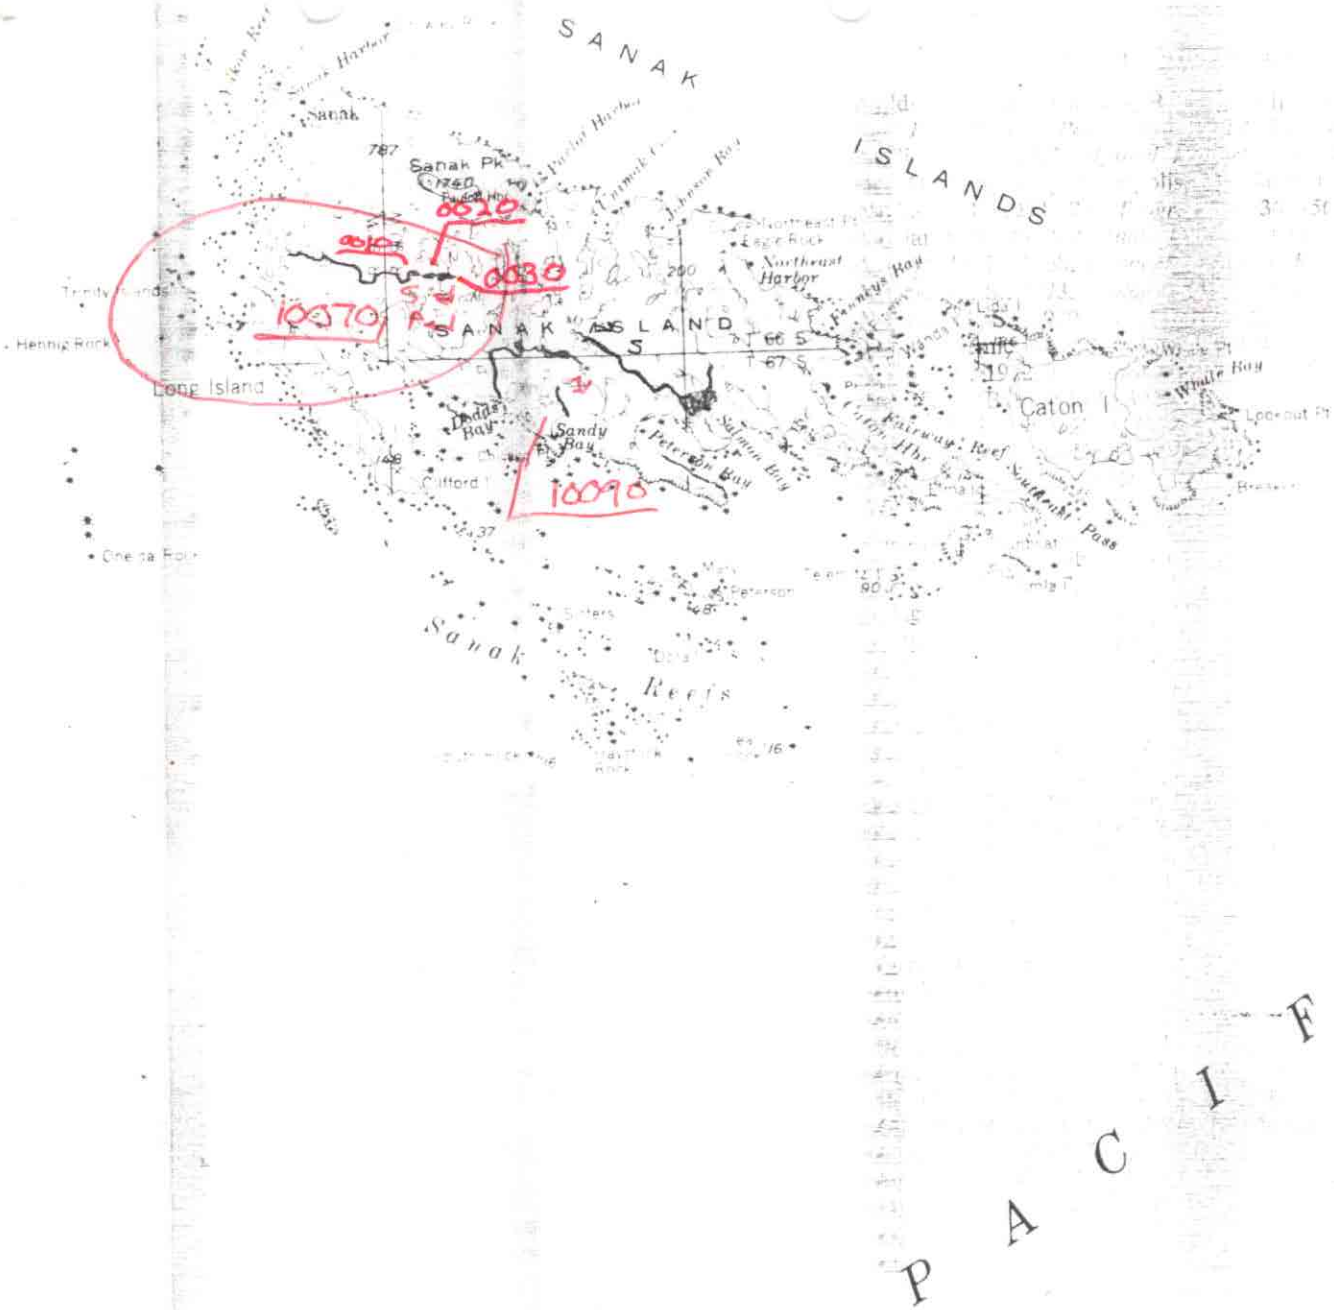

SCALE 1:250000