Drafted [illegible] 11/6/86

1986

86-215

State of Alaska
Department of Fish and Game
Public Review Nomination for Waters
Important to Anadromous Species

[X] Addition [ ] Deletion OK SJS 11/8/85

X

Name of Waterbody (if known): _____

Location: 54° 24' 6" N. lat. Stream Flowing into Dodds Bay
162° 43' 12" W. long Sanak Island

Anadromous Waters Catalog Volume and Number _____

USGS 1:63,360 Quadrangle 283-10-10080 4 lakes

or 1:250,000 (if 1:63,360 not available) False Pass

Species	Date(s) Observed	Stage(s) (Spawning, Rearing, Migration)
Sockeye Salmon	9-8-85	2,600 Some spawning, some still schooled
Pink Salmon	9-8-85	2,500 spawning

Comments: Please provide any clarifying information in addition to identification on Anadromous Waters Catalog Public Review Maps.

600 sockeye in right Fk. lake, rest in left Fk. lake. Pinks in both Forks below lakes and below Forks.

ADF&G Survey - Gruman Goose

Name of Observer (please print) Arnold R. Shaul

Date: 9-11-85 Signature: Arnold R. Shaul

OK [signature] 11/4/85

ALASKA DEPT. OF FISH & GAME

SEP 12 1985

HABITAT REGIONAL OFFICE

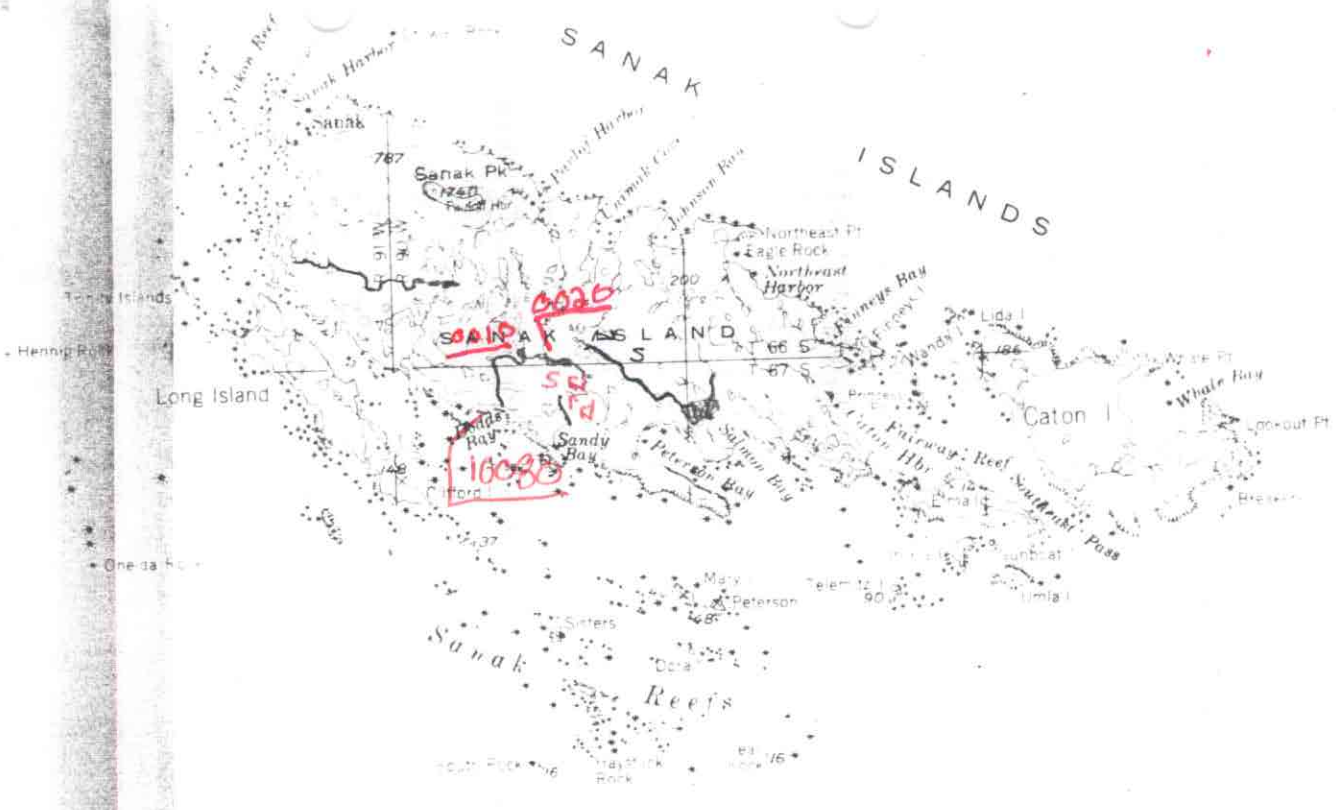
SANAK ISLANDS
Sanak
Sanak Pk
Northeast Pt
Eagle Rock
Northeast Harbor
Long Island
Caton I
Whale Bay
Lookout Pt
Sandy Bay
Peterson Bay
Salmon Bay
Fairway Reef
Southeast Pass
Sanak Reefs
Peterson
Sisters
Mary
Umlaut
Henning Rock
Oneida Rock
Lida I
Wanda I
Fanneys Bay
Johnson Bay
Sanak Harbor
Yukon Reef
Clifford
Sandy Bay
Peterson Bay
Caton Hbr
Telemitz I
Sunboat
Breakers
Whale Pt
Pinnacle
Ermaid
Trinity Islands
SCALE 1:250000

PACIFI

MEMORANDUM (Brief Communications) **State of Alaska**

TO:	Name: Arnie Shaul	Dept./Div./Sect.: Comm Fish/ Kodiak	Mail Stop
FROM:	Name: Stewart Seaberg	Dept./Div./Sect.: Habitat / Reg II / Anch	Telephone: 267-2285
SUBJ.:	Anadromous Stream Catalog Nominations		Date: 10/9/85

as we discussed I am returning your nominations with a blank map so you can draw these streams on.

Since we have already begun to draft the changes I would greatly appreciate you returning these A.S.A.P. Thanks

ALASKA DEPT. OF FISH & GAME
OCT 21 1985
REGION II
HABITAT DIVISION

I can't recall which lake on the map at Sandy Bay where I found reds

02-001C (12/80)
Ps