State of Alaska
Department of Fish and Game
Nomination for Waters
Important to Anadromous Fish

AWC Volume SE SC (SW) W AR IN USGS Quad UGASHIK B-2

Anadromous Water Catalog Number of Waterway 262-85-10098

Name of Waterway * KAYAKLIUT CREEK USGS name ____ Local name ____

Addition X Deletion ____ Correction ____ Backup Information ____

For Office Use

Nomination # 95 129	[signature] Regional Supervisor — Date 12/23/94
Revision Year: 1995	[signature] — Date 12/22/94
Revision to: Atlas ____ Catalog ____ Both X	[signature] Drafted — Date 12/28/94
Revision Code: A-2	

OBSERVATION INFORMATION

Species	Date(s) Observed	Spawning	Rearing	Migration	Anadromous
PINK	SEE ATTACHED			X	X

IMPORTANT: Provide all supporting documentation that this water body is important for the spawning, rearing or migration of anadromous fish, including: number of fish and life stages observed; sampling methods, sampling duration and area sampled; copies of field notes; etc. Attach a copy of a map showing location of mouth and observed upper extent of each species, as well as any other information such as: specific stream reaches observed as spawning or rearing habitat; locations, types, and heights of any barriers; etc.

Comments: ADDITION BASED ON HISTORICAL ADF&G-CFMD SALMON ESCAPEMENT SURVEY DATA (ATTACHED).

ALASKA DEPT. OF FISH & GAME
DEC 16 1994
REGION II
HABITAT AND RESTORATION DIVISION

Name of Observer (please print) VARIOUS ADFG EMPLOYEES

Date: 11/2/94 Signature: by Edward W. Weiss

Address: HABITAT & RESTORATION DIVISION
ANCHORAGE, AK 99518-1599

This certifies that in my best professional judgement and belief the above information is evidence that this waterbody should be included in or deleted from the Catalog of Waters Important for Spawning, Rearing or Migration of Anadromous Fishes per AS 16.05.870.

Signature of Area Biologist: [signature] 12-14-94 Rev. 7/93

Alaska Department of Fish and Game
Salmon Escapement Surveys, 79
(Aerial Surveys Unless Noted in Remarks)

Stream	Date MM-DD-YY	Observer	Visibility Str	Mou	Bay	Fish in Stream Reds	Coho	Pink	Chum	Build Up Fish Mouth	Bay	Observer Remarks
KAYAKLIUT CREEK												
262-861	8-21-79	MALLOY				0	0	400	500			
262-861	8-23-83	~~PROBASCO~~				0	0	200	0	100Ch		DRY
262-861	8-13-84	~~PROBASCO~~				0	0	0	0			1400 P OFF MOUTH
262-861	8-26-85	~~PROBASCO~~				0	0	200	0			200 P OFF MOUTH
262-861	7-26-89	MALLOY	e	e	e	0	0	0	0		4000P	Fish on east side in mouth along beach.
262-861	8-26-89	~~PROBASCO~~ PROKOPOWICH	e	e		0	0	9000	0	300P		

Salmon Escapement Observations Report Date 10/29/93

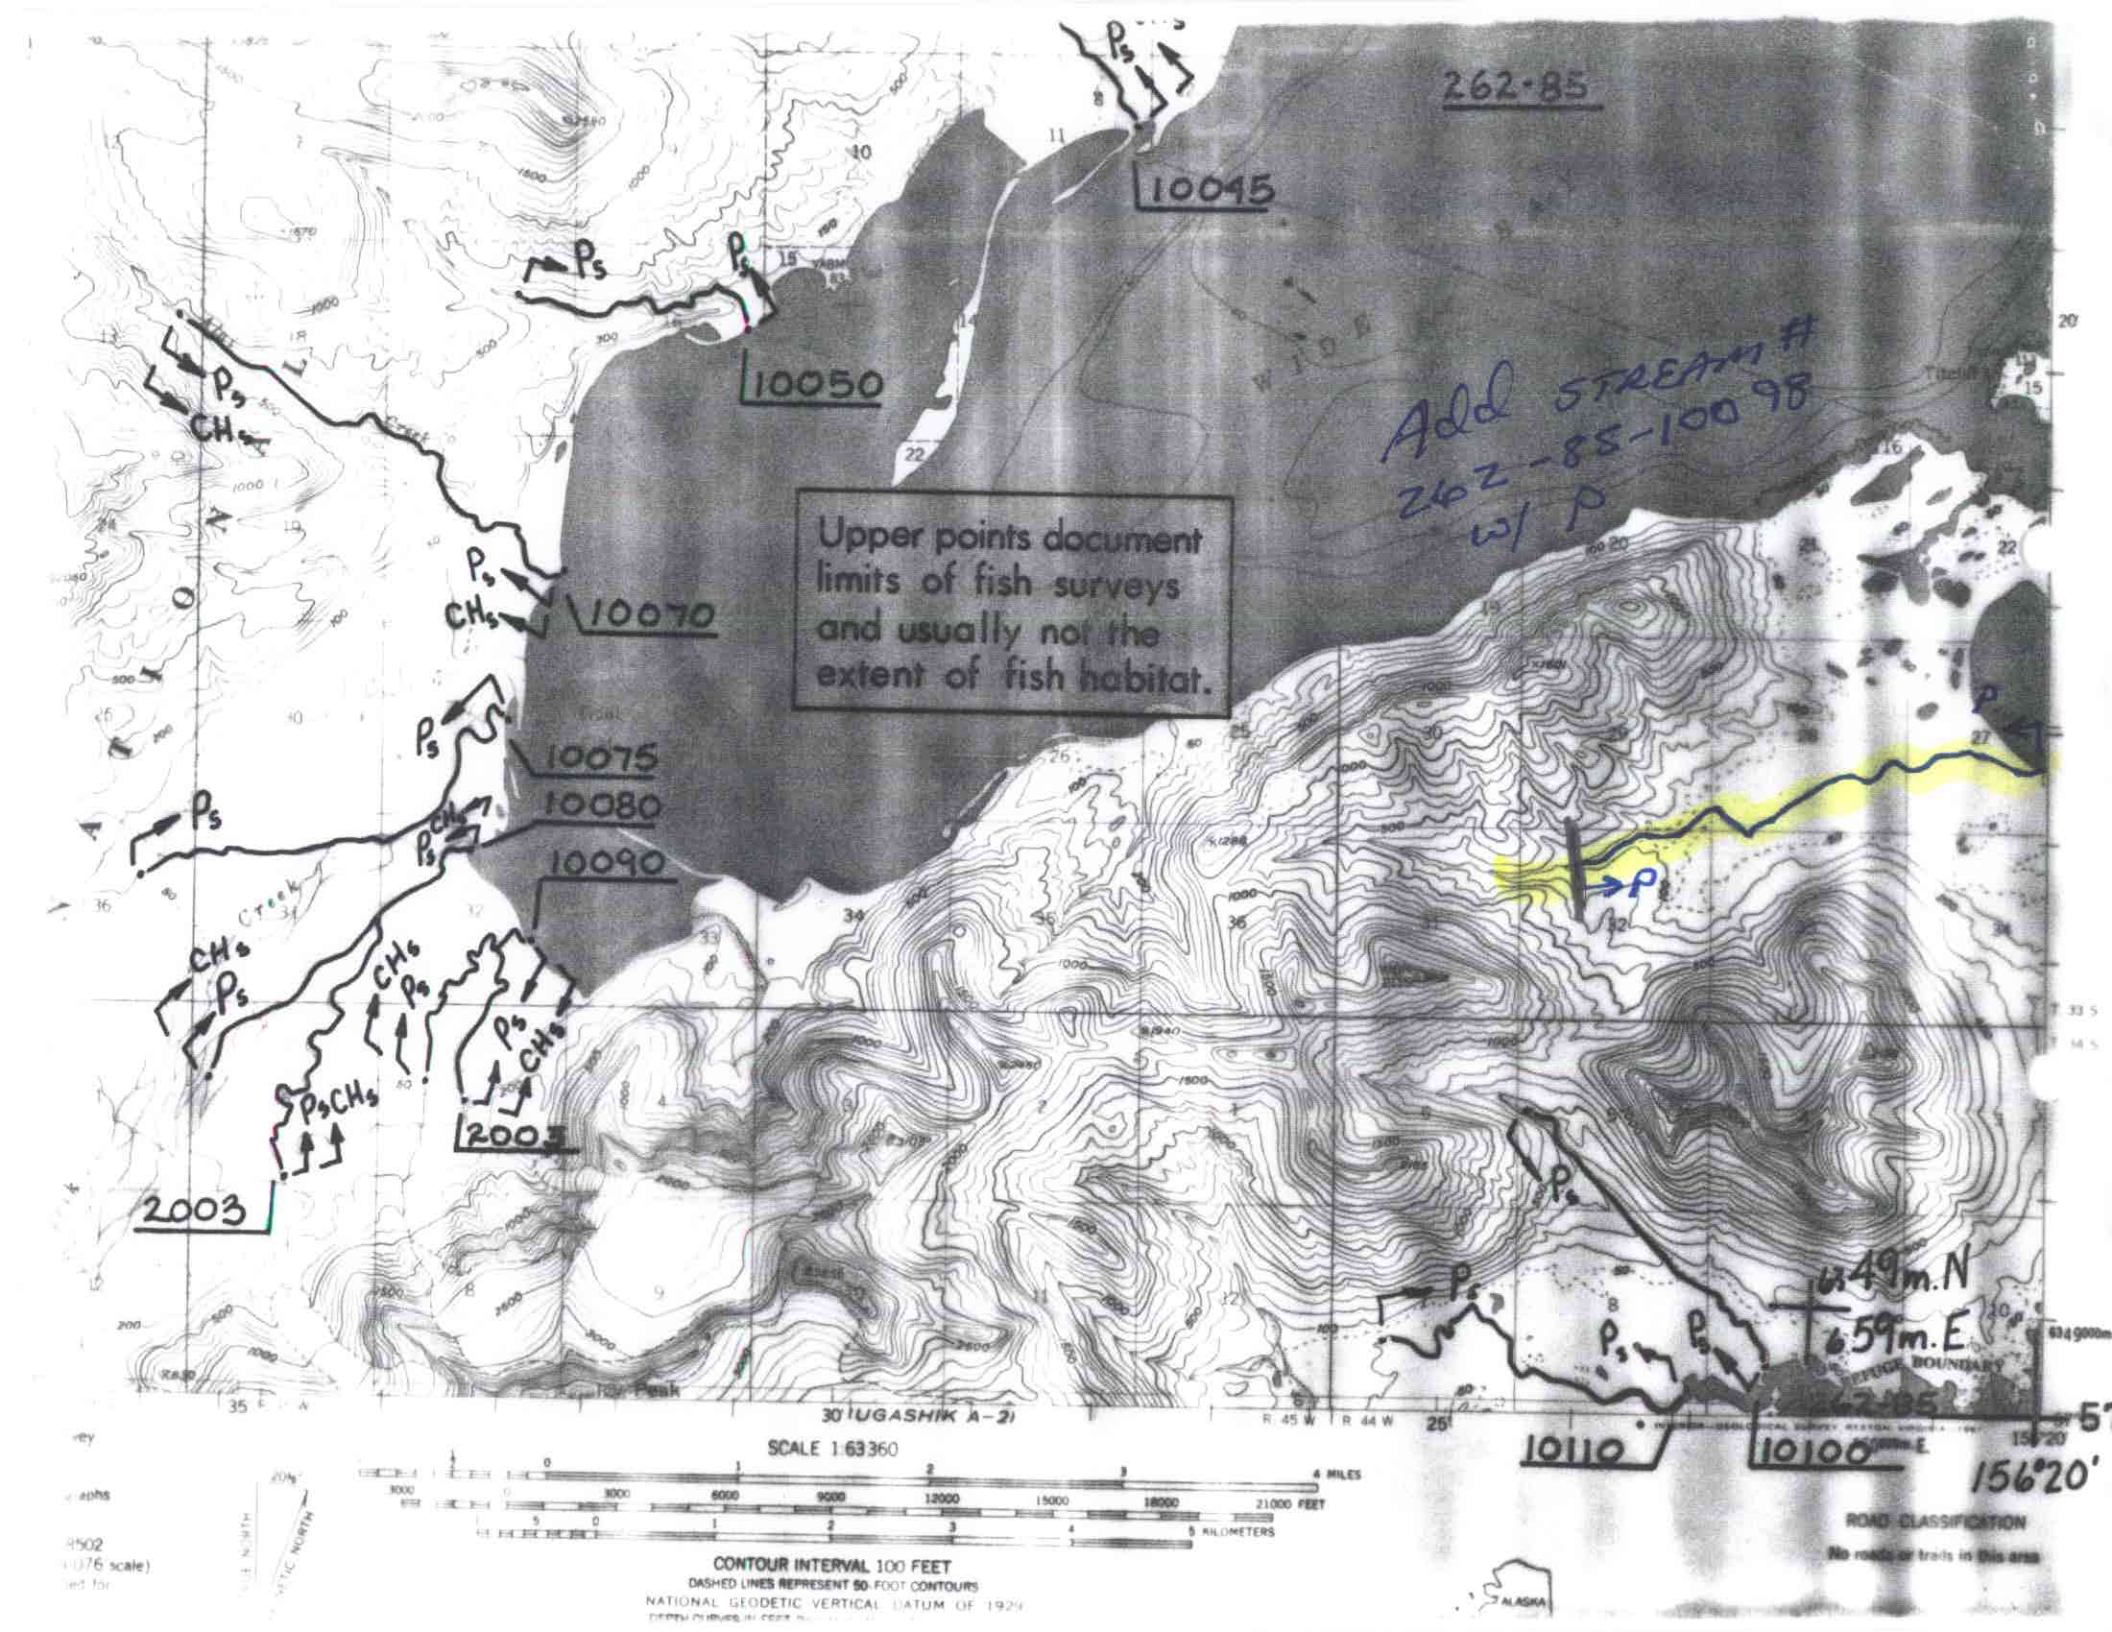
262-85
10045
10050
10070
10075
10080
10090
2003
2003
10110
10100
Add STREAM #
262-85-10098
w/ P
Upper points document limits of fish surveys and usually not the extent of fish habitat.
Creek
Ps
CHs
PsCHs
P
6349m.N
659m.E
156°20'
UGASHIK A-2
SCALE 1:63360
4 MILES
21000 FEET
5 KILOMETERS
CONTOUR INTERVAL 100 FEET
DASHED LINES REPRESENT 50-FOOT CONTOURS
NATIONAL GEODETIC VERTICAL DATUM OF 1929
ROAD CLASSIFICATION
No roads or trails in this area
ALASKA