Stream track correction

Blue line- AWC

Red line- stream path
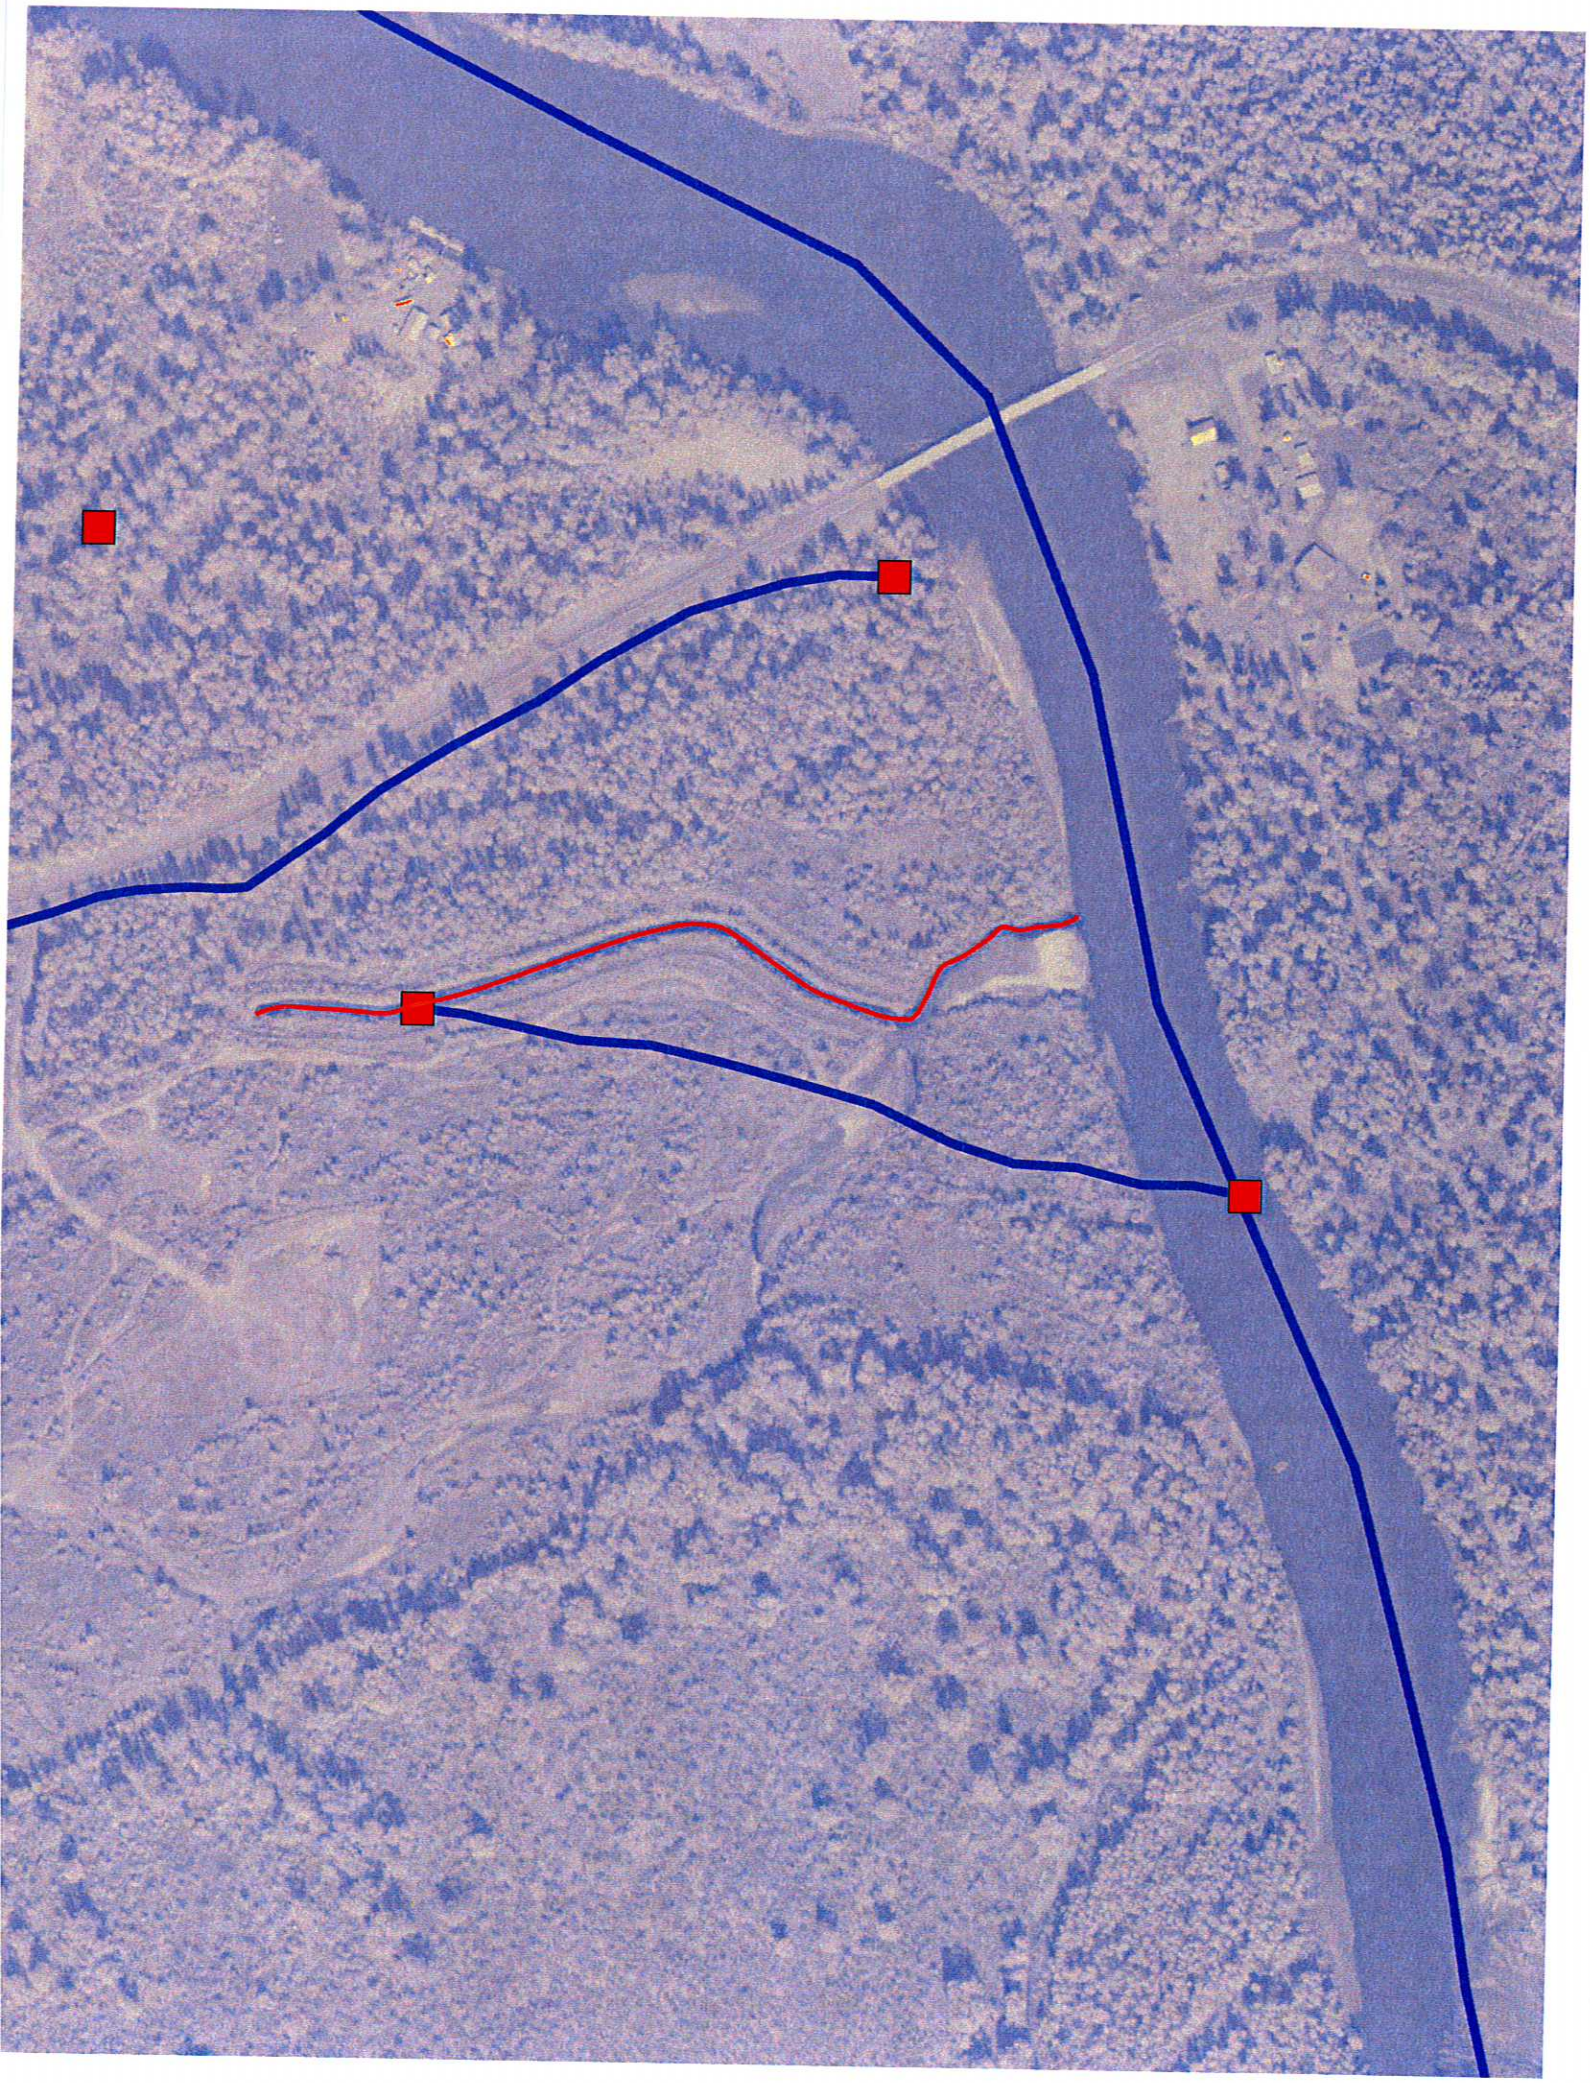
Joe Hitselberger
ADF&G
Habitat Biologist
(907) 465-4346