cc Al Sorenson
Jim Wilson
Fish & Game

Date: 23 SEPT 1978

Fish Stream Survey Report

102-70-058

Camp CRAIG / So. HARRIS SALE Stream Name(ID) [illegible]

Road# 4014 Station# _____ Unit# 2 RP# _____

Quad Map CRAIG B-3 Section 28 Chick Map _____ Section _____

Fish Present	Yes	No
Above Road Crossing		✓
Below Road Crossing		✓
Within Unit Boundary		✓
Below Unit Boundary		✓

Species Present/Stage of Development N/A

Type of Fish Habitat NONE

Salmon Spawning Area _____ sq yds Describe _____
Salmon Rearing Area _____ sq yds Describe _____
Other _____ Area _____ sq yds Describe _____

Stream Sketch or Map: Attach supplement if necessary:
SEE SUPPLEMENT
UNIT TRAVERSE MAP

Method(s) used to determine presence of fish:

Date	#Fish	Approx Length	Gear	Length of Time Fished
23 SEPT	Ø	—	SHOCKER	20-30 MIN

Is future fish habitat enhancement possible? Yes _____ No ✓
If yes Describe

Road and Unit boundary/fish stream intersection(s)
Marked with aluminum metal tags Yes _____ No ✓
Fish stream(s) flagged with blue stripe tape Yes _____ No ✓
Stream(s) traversed-If so attach traverse notes Yes _____ No ✓
Additional parameter information necessary, Yes _____ No ✓
If so attached completed fish stream parameter
Data form

Pertinent Wildlife Information: NONE
NO DEER OR BEAR SIGN SEEN

BRIDGE CROSSING ON #4016 ROAD OVER FORK OF TROCADERO LOOKS GOOD - PROTECT FOR WATER QUALITY

Comments: MAIN STREAM IS A MAJOR FEEDER OF THE TROCADERO
SHOCKED MAIN STREAM FLOWING OUT OF UNIT.
NO FISH FOUND AFTER EXTENSIVE SHOCKING.
APPROX 200' ABOVE S.W. UNIT BOUNDARY WAS A NEARLY VERTICAL 30' HIGHWATER FALL FOLLOWED BY A SERIES OF 6' TO 10' FALLS IN A NARROW V-CUT W/ 25'-30' HIGH BANKS. ALL STREAMS IN UNIT ARE FEEDERS TO THIS MAIN STREAM. PROTECT FOR WATER QUALITY

Survey Crew Members: Signature Date

Laura A. Moll 23 SEPT 1978
[illegible] [illegible]

Report Reviewed By [illegible] Forester 9-25-78
Signature Title Date

Recommendations:

See comments

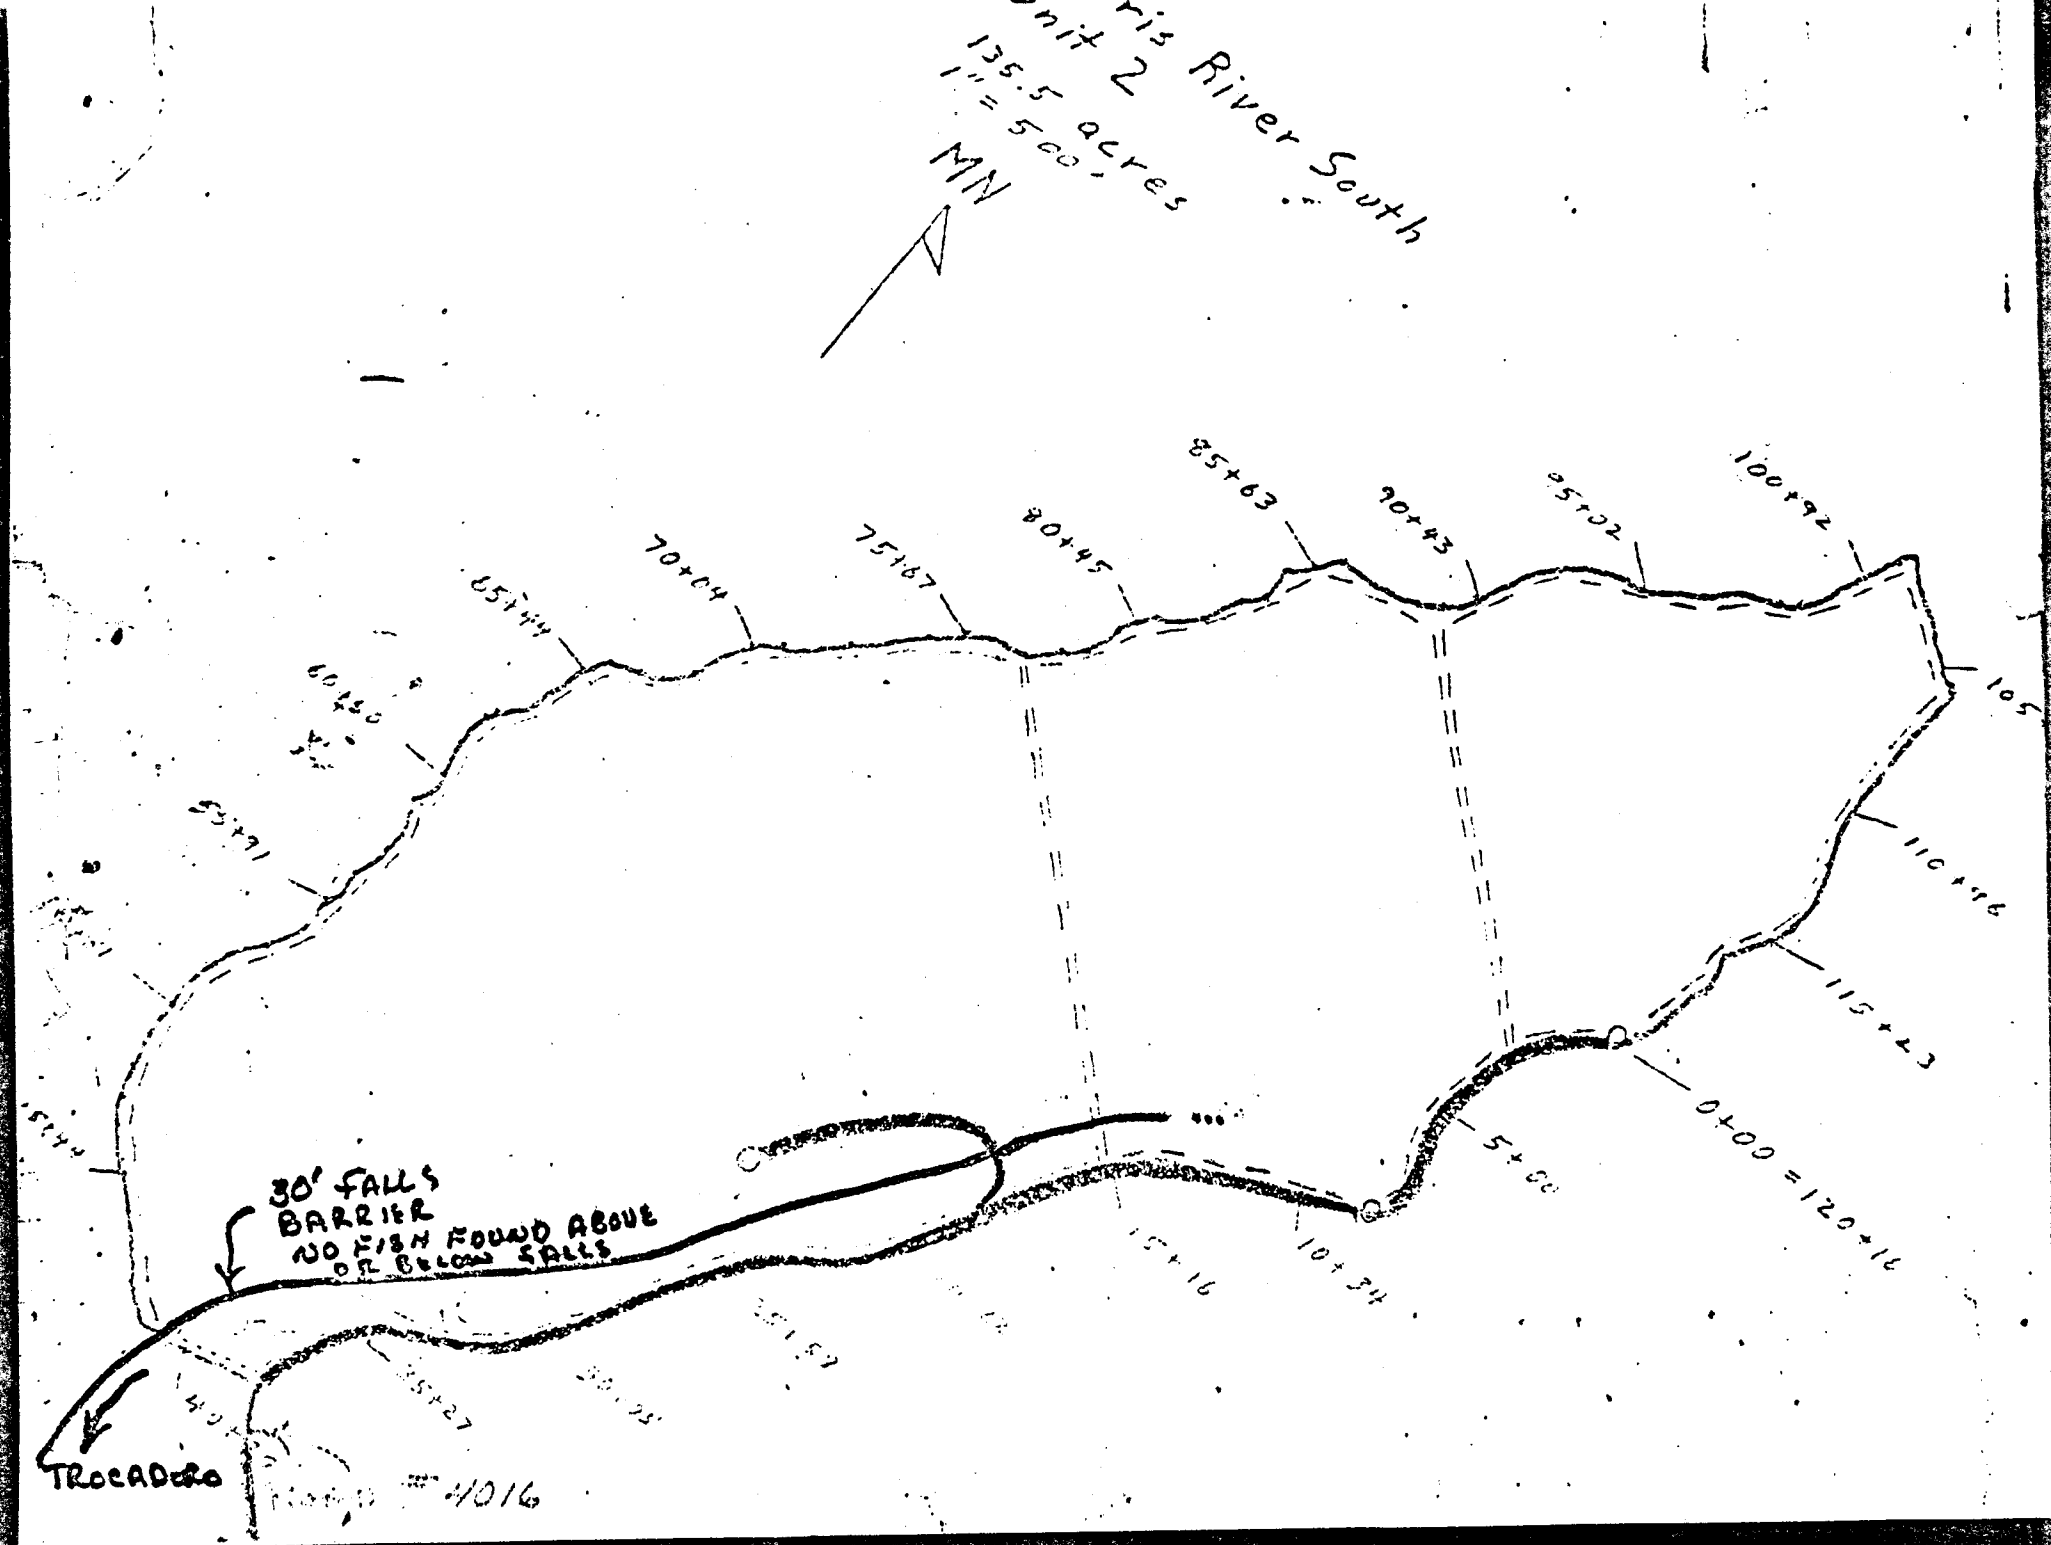

ris River South
nit 2
135.5 acres
1" = 500'
MN
85+63
90+43
95+02
100+92
105
110+96
115+23
0+00 = 120+16
5+00
10+34
15+16
70+04
75+67
80+45
65+44
60+50
55+91
30' FALLS
BARRIER
NO FISH FOUND ABOVE
OR BELOW FALLS
TROCADERO
#4016